


CERTIFIED RECORD OF LAND CORNER MONUMENTATION

History of original corner establishment:

W.B. Barr made the original survey under Contract No. 355, dated June 14, 1880. At the $\frac{1}{4}$ corner location common to Sections 17 & 20, T 8 S R 45 E, he set a marked basalt rock 16 x 10 x 10 with a raised mound of stone alongside as per instructions.

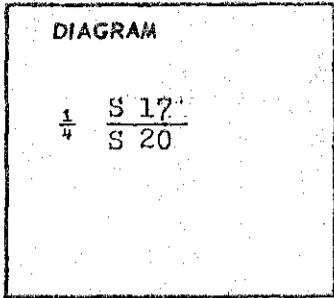

Description of corner evidences found:

At the above mentioned $\frac{1}{4}$ corner location, after an extensive search, I found a basalt stone 17 x 10 x 9 setting upright in a mound of stone. This stone fit very closely the description of the original stone, and the markings were very dim. I also found the GLO calls along this line to be erroneous and not fitting any of the topography.

Description of monument and accessories I established to perpetuate the original location of this corner

At the $\frac{1}{4}$ corner location I set a 2" x 30" galv. iron pipe with brass cap along south side of the original stone, leaving the stone in its original position. I then placed a large mound of stone about the monument and stone as it was impossible to bury the pipe. There was no accessories available.

Cap stamped:
T 8 S
 $\frac{1}{4}$ S 17
S 20
R 45 E
1980
ORLS 645

REGISTERED
PROFESSIONAL
LAND SURVEYOR

James H. Hambleton
4-9-80

OREGON
JULY 31, 1934
JAMES H. HAMBLETON
645

Office of..... County of.....
State of....., I hereby certify that the within instrument was filed in this office
for record on the day of.....
..... by.....
(COUNTY OFFICIAL) (DEPUTY)

FILED 4-9-80
BAKER COUNTY SURVEYOR
SURVEY NO. 8-45-14