


CERTIFIED RECORD OF LAND CORNER MONUMENTATION

History of original corner establishment:

W.B. Barr made the original survey under Contract No. 355, dated June 14, 1880. At the $\frac{1}{4}$ corner location common to Sections 31 & 32, T 8 S R 45 E, he set a marked basalt rock 12 x 10 x 10 in a raised mound of rock as per instructions.

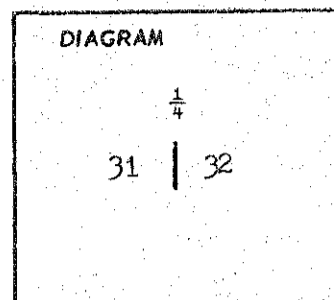

Description of corner evidence found:

At the above mentioned $\frac{1}{4}$ corner location I found a granite type stone 12 x 10 x 10 in place with $\frac{1}{4}$ marked on the west face. Also I found a small mound of rock.

Description of monument and accessories I established to perpetuate the original location of this corner

At the $\frac{1}{4}$ corner location I set a 2" x 30" galv. iron pipe with a brass cap approx. 8" above surface, in a mound of stone. The original stone is placed along the east face of the iron pipe with the markings near the pipe. There was no accessories available.

Cap stamped:

T 8 S

$\frac{1}{4}$

S 31 | S 32

R 45 E

1980

ORLS 645

REGISTERED
PROFESSIONAL
LAND SURVEYOR

James H. Hambleton

4-9-80

OREGON
JULY 10, 1954
JAMES H. HAMBLETON
645

Office of..... County of.....

State of....., I hereby certify that the within instrument was filed in this office

for record on the..... day of.....

..... by.....
(COUNTY OFFICIAL) (DEPUTY)

FILED 4-9-80

BAKER COUNTY SURVEYOR

SURVEY NO. 8-45-15