


CERTIFIED RECORD OF LAND CORNER MONUMENTATION

History of original corner establishment: *NONE*

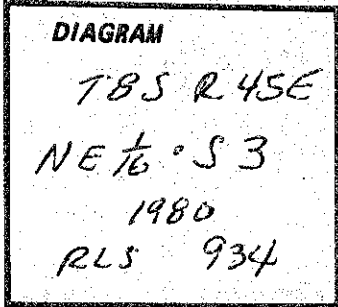

Description of corner evidence found: *NONE*

Description of monument and accessories I established to perpetuate the original location of this corner: *AT CALCULATED POSITION I SET A 2" x 30" GALV. IRON PIPE W/ BRASS CAP STAMPED AS SHOWN ABOVE, FROM WHICH:*

NEW BT, 7" PINE, SCRIBED "NE 1/6 S 3 BT" BEARS N34°E, 15.6 FT.

NEW BT, 7" FIR, SCRIBED "NE 1/6 S 3 BT" BEARS N88 1/4°W, 26.8 FT.

I SET THE 2" PIPE 28" IN GROUND AND SET STONES AROUND IT.

I SET A STEEL POST 3' E. OF COR. W/SIGNS 54-2 & 54-9, AND A STEEL POST 3' S. OF CORNER W/SIGN 54-2.

I PRINTED A RED BAND AROUND BOTH BT'S, AND TAGGED THEM W/SIGN 54-3

REGISTERED
PROFESSIONAL
LAND SURVEYOR

Victor M. McLind

OREGON
JULY 17, 1970
VICTOR M. MCLIND
934

I HEREBY CERTIFY THE ABOVE CORNER MONUMENT WAS ESTABLISHED AS HEREIN DESCRIBED ON JUNE 13, 1980.

WITNESS: Doug McLind

Office of..... County of.....
State of..... I hereby certify that the within instrument was filed in this office
for record on the..... day of....., 19.....
..... by

(COUNTY OFFICIAL)

(DEPUTY)

Form R6-7100-57 (9/71)

FILED Aug. 11, 1980
BAKER COUNTY SURVEYOR
SURVEY NO. 8-45-17

☆ GPO-798-276

Doug