


CERTIFIED RECORD OF LAND CORNER MONUMENTATION

History of original corner establishment: ESTABLISHED IN 1890 BY  
W.B. BARR UNDER G.L.D. CONTRACT NO. 358  
SURVEYOR GENERAL'S RECORDS STATE:  
MARKED BASALT ROCK 12x2x7 FOR 1/4 SEC. COR.,  
ROUND MOUND OF STONE AS PER INSTRUCTIONS.

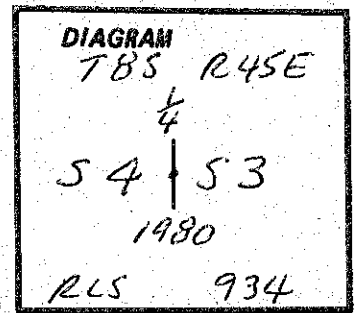

Description of corner evidence found: FOUND BASALT ROCK 12"x3"x7", STANDING UPRIGHT  
6" ABOVE GROUND IN GOOD ROUND MOUND OF STONE. NO DISCERNABLE  
MARKS ARE APPARENT ON STONE.

Description of monument and accessories I established to perpetuate the  
original location of this corner: IN PLACE OF FND. STONE MON. I SET A 2"x30"  
GALV. IRON PIPE W/ BRASS CAP STAMPED AS SHOWN, FROM WHICH:

NEW BT, 7" PINE, SCRIBED "1/4 53 BT" BEARS N 21 1/2° E, 99.3 FT.  
NEW BT, 12" PINE, SCRIBED "1/4 54 BT" BEARS N 9° W, 46.0 FT.

I SET THE 2" PIPE 26" IN GROUND AND SET STONES AROUND IT. BURIED  
STONE MON. ALONGSIDE.

I SET A STEEL POST 3' S. OF MON. W/SIGN 54-4

I PRINTED A RED BAND AROUND BOTH BT'S, AND TAGGED THEM W/SIGN 54-3

REGISTERED  
PROFESSIONAL  
LAND SURVEYOR

*Victor M. McLind*  
OREGON  
JULY 17, 1970  
VICTOR M. McLIND  
934

I HEREBY CERTIFY THE ABOVE CORNER MONUMENT  
WAS RE-ESTABLISHED AS HEREIN DESCRIBED  
ON MAY 8, 1980.

WITNESS: *Doug McLind*

Office of..... County of.....  
State of....., I hereby certify that the within instrument was filed in this office  
for record on the..... day of....., 19.....  
..... by .....

(COUNTY OFFICIAL)

(DEPUTY)

Form R6-7100-57 (9/71)

FILED Aug. 11, 1980  
BAKER COUNTY SURVEYOR  
SURVEY NO. 8-45-19

*Doug*