


CERTIFIED RECORD OF LAND CORNER MONUMENTATION

History of original corner establishment: *NONE*

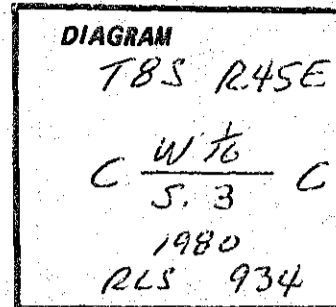

Description of corner evidence found: *NONE*

Description of monument and accessories I established to perpetuate the original location of this corner: *AT CALCULATED POSITION I SET A 2" x 30" GALV. IRON PIPE W/ BRASS CAP STAMPED AS SHOWN ABOVE, FROM WHICH:*  
*NEW BT, 9" PINE, SCRIBED "CW 1/2 S 3 BT" BEARS S18°E, 27.4 FT.*  
*NEW BT, 11" FIR, SCRIBED "CW 1/2 S 3 BT" BEARS N74°W 23.8 FT.*

*I SET THE 2" PIPE 28" IN GROUND, AND SET STONES AROUND IT.*  
*I SET A STEEL POST 3' N. OF COR. W/ SIGNS 54-2 & 54-9*  
*I PRINTED BOTH BT'S WITH A RED BAND, AND TAGGED THEM W/ SIGN 54-3*

REGISTERED  
 PROFESSIONAL  
 LAND SURVEYOR

*Victor M. McLind*

OREGON  
 JULY 17, 1879  
 VICTOR M. McLIND  
 934

I HEREBY CERTIFY THE ABOVE CORNER MONUMENT WAS ESTABLISHED AS HEREIN DESCRIBED ON JUNE 11, 1980.

WITNESS: *Doug McFerd*

Office of..... County of.....  
 State of..... I hereby certify that the within instrument was filed in this office for record on the..... day of....., 19.....  
 ..... by .....  
 (COUNTY OFFICIAL) (DEPUTY)