


CERTIFIED RECORD OF LAND CORNER MONUMENTATION

History of original corner establishment: *NONE*

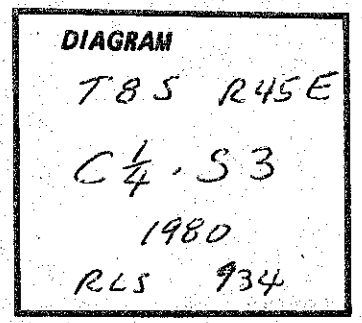

Description of corner evidence found: *NONE*

Description of monument and accessories I established to perpetuate the original location of this corner: *AT CALCULATED POSITION I SET A 2" x 30" GALV. IRON PIPE W/ BRASS CAP STAMPED AS SHOWN ABOVE, FROM WHICH:*

- NEW BT, 13" PINE, SCRIBED "C 1/4 S 3 BT" BEARS N36°W, 8.4 FT.*
- NEW BT, 9" PINE, SCRIBED "C 1/4 S 3 BT" BEARS N82°E, 23.0 FT.*

I SET THE 2" PIPE 28" IN GROUND AND SET STONES AROUND IT.
I SET A STEEL POST 3' N. OF CORNER W/SIGN 54-2, AND A STEEL POST 3' E. OF CORNER W/SIGNS 54-2 & 54-9.
I PAINTED A RED BAND AROUND BOTH BT'S, AND TAGGED THEM W/SIGN 54-3

REGISTERED
PROFESSIONAL
LAND SURVEYOR

Victor M. McLind
 OREGON
 JULY 17, 1970
 VICTOR M. McLIND
 934

I HEREBY CERTIFY THE ABOVE CORNER MONUMENT WAS ESTABLISHED AS HEREIN DESCRIBED ON JUNE 11, 1980.

WITNESS: Doug McFid

Office of..... County of.....
 State of....., I hereby certify that the within instrument was filed in this office
 for record on the..... day of....., 19.....
 by
 (COUNTY OFFICIAL) (DEPUTY)

Form R6-7100-57 (9/71)

FILED Aug. 11, 1980
 BAKER COUNTY SURVEYOR
 SURVEY NO. 8-4S-21

Doug