


CERTIFIED RECORD OF LAND CORNER MONUMENTATION

History of original corner establishment: *NONE*

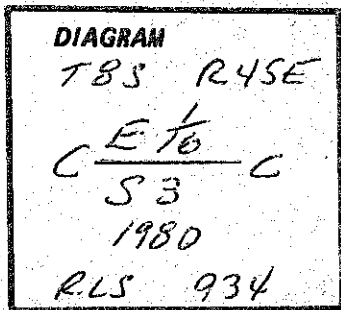

Description of corner evidence found: *NONE*

Description of monument and accessories I established to perpetuate the

original location of this corner: *AT CALCULATED POSITION I SET A 2" X 30" GALV. IRON PIPE W/BRASS CAP STAMPED AS SHOWN ABOVE, FROM WHICH:*

*NEW BT, 9" FIR, SCRIBED "CE 1/6 S3 BT" BEARS N41'E, 32.7 FT.
NEW BT, 11" PINE, SCRIBED "LE 1/6 S3 BT" BEARS S88°W, 20.1 FT.*

*I SET THE 2" PIPE 27" IN GROUND AND SET STONES AROUND IT.
I SET A STEEL POST 3' N. OF COR. W/SIGN 54-2, AND A STEEL POST
3' W. OF COR. W/SIGNS 54-2 & 54-A.
I PAINTED A RED BAND AROUND BOTH BT'S, AND TAGGED THEM W/SIGN 54-3.*

REGISTERED
PROFESSIONAL
LAND SURVEYOR

Victor M. McLind

OREGON
JULY 17, 1970
VICTOR M. MCLIND
934

*I HEREBY CERTIFY THE ABOVE CORNER MONUMENT
WAS ESTABLISHED AS HEREIN DESCRIBED ON
JUNE 4, 1980.*

WITNESS: Doug McLeod

Office of..... County of.....
State of....., I hereby certify that the within instrument was filed in this office
for record on the..... day of....., 19.....
..... by
(COUNTY OFFICIAL) (DEPUTY)

Doug