


CERTIFIED RECORD OF LAND CORNER MONUMENTATION

History of original corner establishment: ESTABLISHED IN 1880 BY  
W.B. BARR UNDER G.L.O. CONTRACT NO. 358.

SURVEYOR GENERAL'S RECORDS STATE:  
MARKED BASALT ROCK 36x30x30 ACCORDING  
TO INSTRUCTIONS FOR 1/4 SEC, CORNER FROM  
WHICH PINE 6 IN DIAM. BEARS WEST 14 LKS. DIST.

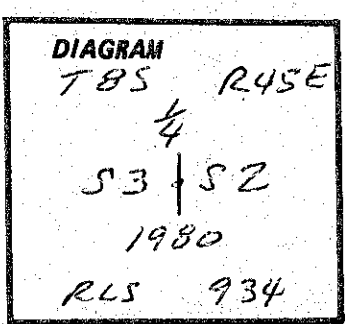

Description of corner evidence found: NONE

Description of monument and accessories I established to perpetuate the  
original location of this corner: AT PROPORTIONED LOCATION I SET A 2" x 30" GALV. IRON PIPE  
W/ BRASS CAP STAMPED AS SHOWN ABOVE, FROM WHICH:

- NEW BT, 13" PINE, SCRIBED "1/4 S3 BT" BEARS S8°W, 43.0 FT.
- NEW BT, 7" FIR, SCRIBED "1/4 S2 BT" BEARS N36°E, 33.8 FT.

I SET THE 2" PIPE 27" IN GROUND AND SET STONES AROUND IT.  
I SET A STEEL POST 3' N. OF COR. W/ SIGNS 54-2 & 54-4  
I PAINTED A RED BAND AROUND BOTH BT'S, AND TAGGED THEM W/ SIGN 54-3

REGISTERED  
PROFESSIONAL  
LAND SURVEYOR

*Victor M. Mc Lind*

OREGON  
JULY 17, 1970  
VICTOR M. McLIND  
934

I HEREBY CERTIFY THE ABOVE CORNER MONUMENT  
WAS RE-ESTABLISHED AS HEREIN DESCRIBED  
ON JUNE 4, 1980.

WITNESS: *Doug Mc Lind*

Office of..... County of.....  
State of....., I hereby certify that the within instrument was filed in this office  
for record on the..... day of....., 19.....  
..... by .....

(COUNTY OFFICIAL)

(DEPUTY)