


CERTIFIED RECORD OF LAND CORNER MONUMENTATION

History of original corner establishment: *NONE*

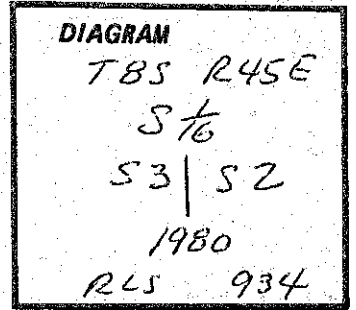

Description of corner evidence found: *NONE*

Description of monument and accessories I established to perpetuate the original location of this corner: *AT CALCULATED POSITION I SET A 2" x 30" GALV. IRON PIPE W/BASS CAP STAMPED AS SHOWN ABOVE, FROM WHICH:*
NEW BT, 10" W, FIR, SCRIBED "S 1/6 S 3 BT" BEARS S 85 1/2° W, 21.0 FT.
NEW BT, 10" W, FIR, SCRIBED "S 1/6 S 2 BT" BEARS N 21 1/2° E, 17.6 FT.

I SET THE 2" PIPE 28" IN GROUND AND SET STONES AROUND IT.
I SET A STEEL POST 3' N. OF CORNER W/SIGNS 54-2 AND 54-9
I PAINTED A RED BAND AROUND BOTH BT'S, AND TAGGED THEM W/SIGN 54-3.

REGISTERED
PROFESSIONAL
LAND SURVEYOR

Victor M. McLine

OREGON
JULY 17, 1970
VICTOR M. MC LINE
934

I HEREBY CERTIFY THE ABOVE CORNER MONUMENT WAS ESTABLISHED AS HEREIN DESCRIBED ON JUNE 6, 1980.

WITNESS: Doug McLine

Office of..... County of.....
 State of....., I hereby certify that the within instrument was filed in this office
 for record on the..... day of....., 19.....
 by
 (COUNTY OFFICIAL) (DEPUTY)