


CERTIFIED RECORD OF LAND CORNER MONUMENTATION

History of original corner establishment: ESTABLISHED IN 1880 BY
W.B. BARR UNDER G.L.D. CONTRACT NO. 358
SURVEYOR GENERAL'S RECORDS STATE:

MARKED BASALT ROCK 15 X 12 X 10 ACCORDING
TO INSTRUCTIONS FOR COR. TO SEC. 3 X 4 X 9 X 10
FROM WHICH;

PINE 40 IN. IN DIAM. BEARS N 62° W 72 LKS DIST.
PINE 30 IN. IN DIAM. BEARS S 40° W 15 LKS DIST.

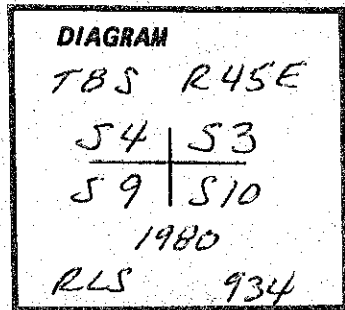

Description of corner evidence found: FND. BASALT ROCK 15" X 12" X 10" WITH 3 NOTCHES ON
ONE EDGE, LYING IN RING OF STONE, FROM WHICH:

OBT, NOW ROTTED PINE STUMP, APPROX. 30" DIAM., BEARS S 20° W
9.9 FT. TO FACE (11.2 FT. TO CENTER.) NO SCRIBES, OTHER OBT MISSING.

Description of monument and accessories I established to perpetuate the

original location of this corner: IN PLACE OF STONE MON. I SET A 2" X 30" GALV. IRON PIPE
W/ BRASS CAP STAMPED AS SHOWN ABOVE, FROM WHICH:

NEW BT, 7" PINE, SCRIBED "TBS R45E S10 BT" BEARS S 69° E, 12.7 FT.
NEW BT, 11" PINE, SCRIBED "TBS R45E S3 BT" BEARS N 26° E, 29.0 FT.
NEW BT, 6" PINE, SCRIBED "TBS R45E S4 BT" BEARS N 38° W, 12.1 FT.
NEW BT, 13" PINE, SCRIBED "TBS R45E S9 BT" BEARS S 55° W, 10.9 FT.

I SET THE 2" PIPE 28" IN GROUND AND BURIED THE STONE MON. ALONGSIDE,
AND SET STONES AROUND PIPE.

I SET A STEEL POST 3' E. OF COR. AND A STEEL POST 3' N. OF COR.,
W/ SIGNS 54-2 AND 54-4.

I PAINTED A RED BAND AROUND ALL BT'S, AND TAGGED THEM W/ SIGN 54-3.

REGISTERED
PROFESSIONAL
LAND SURVEYOR

Victor M. McLeod

OREGON
JULY 17, 1970
VICTOR M. MCLIND
934

I HEREBY CERTIFY THE ABOVE CORNER MONUMENT
WAS RE-ESTABLISHED AS HEREIN DESCRIBED ON
MAY 27, 1980.

WITNESS: *Doug McFid*

Office of..... County of.....

State of....., I hereby certify that the within instrument was filed in this office
for record on the..... day of....., 19.....

..... by
(COUNTY OFFICIAL) (DEPUTY)