


E-14, TBS, R45E

CERTIFIED RECORD OF LAND CORNER MONUMENTATION

History of original corner establishment: *NONE*

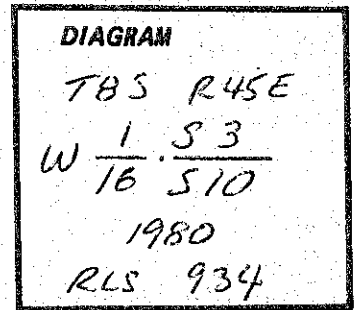

Description of corner evidence found: *NONE*

Description of monument and accessories I established to perpetuate the original location of this corner: *AT PROPORTIONED POSITION I SET A 2" X 30" GALV. IRON PIPE W/ BRASS CAP STAMPED AS SHOWN, FROM WHICH:*

- NEW BT, 11" FIR, SCRIBED "W $\frac{1}{16}$ S 3 BT" BEARS N 15 $\frac{1}{2}$ ° E, 54.8 FT.*
- NEW BT, 12" FIR, SCRIBED "W $\frac{1}{16}$ S 10 BT" BEARS S 34° W, 10.6 FT.*

I SET THE 2" PIPE 27" IN GROUND AND SET STONES AROUND IT.
I SET A STEEL POST 3' W. OF COR. W/ SIGNS 54-2 AND 54-9.
I PAINTED A RED BAND AROUND ALL BT'S, AND TAGGED THEM W/ SIGN 54-3

REGISTERED
PROFESSIONAL
LAND SURVEYOR

Victor M. Mc Lind

OREGON
JULY 17, 1970
VICTOR M. MCLIND
934

I HEREBY CERTIFY THE ABOVE CORNER MONUMENT WAS ESTABLISHED AS HEREIN DESCRIBED ON JUNE 12, 1980.

WITNESS: *Doug Mc Lind*

Office of..... County of.....
 State of..... I hereby certify that the within instrument was filed in this office
 for record on the..... day of....., 19.....
 by.....
 (COUNTY OFFICIAL) (DEPUTY)

Form R6-7100-57 (9/71)

FILED Aug. 11, 1980
 BAKER COUNTY SURVEYOR
 SURVEY NO. 8-45-29

☆ GPO-798-276