

CERTIFIED RECORD OF LAND CORNER MONUMENTATION


History of original corner establishment: ESTABLISHED IN 1880 BY W.B. BARR UNDER G.L.O. CONTRACT NO. 358.

SURVEYOR GENERAL'S RECORDS STATE:

MARKED BASALT ROCK 14x8x5 FOR 1/4 SEC. COR FROM WHICH:

PINE 8 IN. DIAM. BEARS N 57° E 19 LKS. DIST.

PINE 15 IN DIAM. BEARS S 70° E 30 LKS. DIST

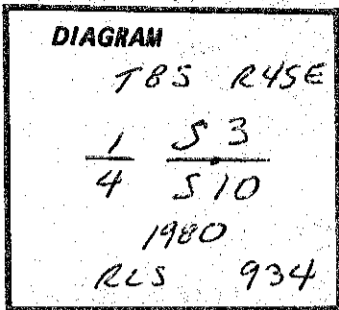

Description of corner evidence found: FND. BASALT ROCK 14"x8"x5", 8" ABOVE GROUND, IN GOOD CONDITION, WITH "1/4" ON S. FACE, FROM WHICH:

OBT, NOW ROTTED PINE STUMP, NO MARKS VISIBLE, BEARS N 57° E 12.5 FT. (19 LKS.)

OBT, NOW ROTTED PINE STUMP, NO MARKS VISIBLE, BEARS S 70° E 19.8 FT. (30 LKS.)

Description of monument and accessories I established to perpetuate the

original location of this corner: IN PLACE OF FND STONE MON. I SET A 2"x30" GALV. IRON PIPE W/BASS CAP STAMPED AS SHOWN, FROM WHICH:

NEW BT, 7" FIR, SCRIBED "1/4 S 3 BT" BEARS N 06° E 22.1 FT.

NEW BT, 11" PINE, SCRIBED "1/4 S 10 BT" BEARS S 11 1/2° E, 14.1 FT.

I SET THE 2" PIPE 28" IN GROUND, BURIED STONE MON. ALONGSIDE, AND SET STONES AROUND PIPE.

I SET A STEEL POST 3' FROM COR. W/SIGN 54-4

I PAINTED A RED BAND AROUND BOTH BT'S, AND TAGGED THEM W/SIGN 54-3

REGISTERED PROFESSIONAL LAND SURVEYOR

Victor M. Mc Lind

OREGON JULY 17, 1970 VICTOR M. MCLIND 934

I HEREBY CERTIFY THE ABOVE CORNER MONUMENT WAS RE-ESTABLISHED AS HEREIN DESCRIBED ON MAY 26, 1980.

WITNESS: *Doug Mc Lind*

Office of..... County of..... State of..... I hereby certify that the within instrument was filed in this office for record on the..... day of....., 19..... by..... (COUNTY OFFICIAL) (DEPUTY)