


CERTIFIED RECORD OF LAND CORNER MONUMENTATION

History of original corner establishment: *NONE*

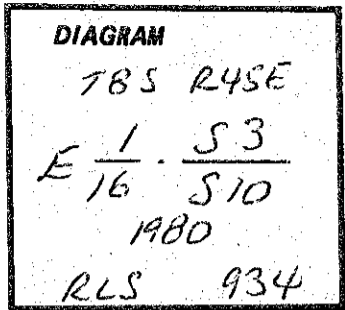

Description of corner evidence found: *NONE*

Description of monument and accessories I established to perpetuate the original location of this corner: *AT CALCULATED POSITION I SET A 2" X 30" GALV. IRON PIPE W/ BRASS CAP STAMPED AS SHOWN ABOVE, FROM WHICH:*

- NEW BT, 9" PINE, SCRIBED "E 1/16 S 10 BT" BEARS S 13 1/4° E, 31.3 FT.*
- NEW BT, 7" FIR, SCRIBED "E 1/16 S 3 BT" BEARS N 11° E, 40.7 FT.*

I SET THE 2" PIPE 28" IN GROUND AND SET STONES AROUND IT. I SET A STEEL POST 3' E. OF COR. W/ SIGNS 54-2 & 54-9.

I PAINTED A RED BAND AROUND BOTH BT'S, AND TAGGED THEM W/ SIGN 54-3

REGISTERED
PROFESSIONAL
LAND SURVEYOR

Victor M. McLind

OREGON
JULY 17, 1970
VICTOR M. McLIND
934

I HEREBY CERTIFY THE ABOVE CORNER MONUMENT WAS ESTABLISHED AS HEREIN DESCRIBED ON JUNE 12, 1980.

WITNESS: Doug McFord

Office of..... County of.....
State of....., I hereby certify that the within instrument was filed in this office
for record on the..... day of....., 19.....
..... by

(COUNTY OFFICIAL) (DEPUTY)