

CERTIFIED RECORD OF LAND CORNER MONUMENTATION


History of original corner establishment: ESTABLISHED IN 1880 BY W.B. BARR UNDER G.L.O. CONTRACT No. 358.

SURVEYOR GENERAL'S RECORDS STATE:

MARKED BASALT ROCK 15x12x12 ACCORDING TO INSTRUCTIONS FOR CORNER TO SEC. 2, 3, 10, 11 FROM WHICH:

FIR 10" DIAM. BEARS N5°W 15 LKS. DIST.

FIR 8" DIAM. BEARS S10°E 15 LKS. DIST.

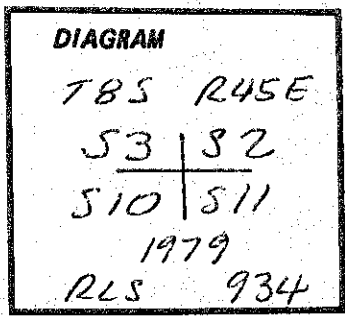

Description of corner evidence found: FND. BASALT ROCK 15"x12"x12" WITH 5 NOTCHES ON S. AND 2 NOTCHES ON E. EDGES, FROM WHICH:

OBT, NOW 18" POTTED LOG ON GROUND, SHOWS SCRIBE "S" ON BARK, BEARS S10°E, 9.9 FT. OTHER OBT IS MISSING.

Description of monument and accessories I established to perpetuate the

original location of this corner: IN PLACE OF FND ROCK MON. I SET A 2"x30" GALV.

IRON PIPE W/ BRASS CAP STAMPED AS SHOWN ABOVE, FROM WHICH:

NEW BT, 9" FIR, SCRIBED "TBS R45E S 2 BT" BEARS N6½°E, 27.9 FT.

NEW BT, 10" FIR, SCRIBED "TBS R45E S 11 BT" BEARS S 59°E, 36.6 FT.

NEW BT, 12" FIR, SCRIBED "TBS R45E S 10 BT" BEARS S 47°W, 42.7 FT.

NEW BT, 15" PINE, SCRIBED "TBS R45E S 3 BT" BEARS N 48°W, 67.3 FT.

I SET THE 2" PIPE 28" IN GROUND AND BURIED ORIG. ROCK MON. ALONGSIDE, AND SET STONES AROUND PIPE.

I SET A STEEL POST 3' W. OF COR. AND A STEEL POST 3' N. OF COR., W/SIGNS 54-2 & 54-4.

I PAINTED A RED BAND AROUND ALL BT'S, AND TAGGED THEM W/SIGN 54-3

REGISTERED PROFESSIONAL LAND SURVEYOR

Victor M. McLind

OREGON JULY 17, 1970 VICTOR M. McLIND 934

I HEREBY CERTIFY THE ABOVE CORNER MONUMENT WAS RE-ESTABLISHED AS HEREIN DESCRIBED ON OCTOBER 17, 1979.

WITNESS: *George P. Burville*

Office of..... County of.....

State of..... I hereby certify that the within instrument was filed in this office for record on the..... day of....., 19.....

..... by (COUNTY OFFICIAL) (DEPUTY)