


CERTIFIED RECORD OF LAND CORNER MONUMENTATION

History of original corner establishment: CORNER ESTABLISHED IN 1890  
By W.B. BARR UNDER G.L.D. CONTRACT  
SURVEYOR GENERAL'S RECORDS STATE: MARKED BASALT ROCK  
16x10x5 FOR COR. TO SEC. 1x2x11x12 AS PER  
INSTRUCTIONS, FROM WHICH  
PINE 5 IN DIAM BEARS N36°E 31 LKS. DIST  
NO OTHER TREES.

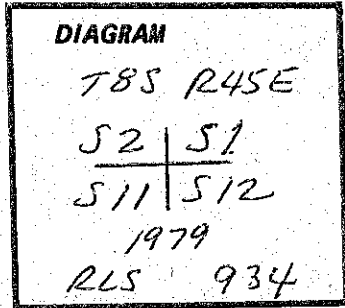

Description of corner evidence found: FOUND STONE 16x13x5 W/MARKS "+", ALSO 1" PIPE  
DRIVEN IN GROUND ALONG SIDE STONE.  
OBT, NOW 29" PINE, BEARS N 36°E, 20.5 FT. AS PER REC.  
HAS BEEN RECENTLY OPENED AND SHOWS SCRIBES "S, "

Description of monument and accessories I established to perpetuate the  
original location of this corner: AT POSITION ESTABLISHED BY PND. NE: OBT I SET A 2"x30"  
GALV. IRON PIPE W/BRASS CAP STAMPED AS SHOWN ABOVE, FROM WHICH:  
NEW BT, 14" PINE, SCRIBED "T8S R4SE S12 BT" BEARS S 45°E, 10.9 FT.  
NEW BT, 7" PINE, SCRIBED "T8S R4SE S11 AT" BEARS S 73°W, 18.2 FT.  
NEW BT, 9" PINE, SCRIBED "T8S R4SE S2 BT" BEARS N 78°W, 87.4 FT.  
NEW BT, 8" PINE, SCRIBED "T8S R4SE S1 BT" BEARS N 61°E, 38.6 FT.  
I BURIED THE 2" PIPE 28" IN GROUND, DROVE 1" PIPE ALONGSIDE, BURIED STONE MON.  
ALONG-SIDE, AND SET STONES AROUND.  
I SET A STEEL POST 3' FROM CORNER W/SIGN 54-4  
I PAINTED A RED BAND AROUND ALL BT'S AND TAGGED THEM W/SIGNS 54-3

REGISTERED  
PROFESSIONAL  
LAND SURVEYOR

*Victor M. McLind*

OREGON  
JULY 17, 1970  
VICTOR M. MCLIND  
934

I HEREBY CERTIFY THE ABOVE CORNER MONUMENT  
WAS RE-ESTABLISHED AS HEREIN DESCRIBED  
ON OCTOBER 19, 1979.

WITNESS: *George P. Barville*

Office of..... County of.....  
State of....., I hereby certify that the within instrument was filed in this office  
for record on the..... day of....., 19.....  
..... by .....

(COUNTY OFFICIAL) (DEPUTY)