


CERTIFIED RECORD OF LAND CORNER MONUMENTATION

History of original corner establishment: ESTABLISHED IN 1880 BY
W. B. BARR UNDER G.L.O. CONTRACT NO. 358.
SURVEYOR GENERAL'S RECORDS STATE:
MARKED BASALT ROCK 14x12x8 FOR 1/4 SEC. CORNER
RAISED MOUND OF ROCKS AS PER INSTRUCTIONS.

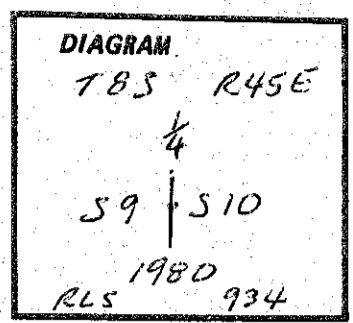

Description of corner evidence found: FND. BASALT ROCK, 14"x12"x8", WITH FAINT "1/4"
ON FACE LYING ON GROUND, IN MOUND OF STONES

Description of monument and accessories I established to perpetuate the
original location of this corner: IN PLACE OF STONE MUN. I SET A 2"x30" GALV. IRON
PIPE W/BRASS CAP STAMPED AS SHOWN, FROM WHICH:
NEW BT, 9" PINE, SCRIBED "1/4 S 10 BT" BEARS N 69° E, 77.7 FT.
NEW BT, 8" PINE, SCRIBED "1/4 S 9 BT" BEARS N 10 1/2° W, 68.6 FT.

I SET THE 2" PIPE 16" IN GROUND AND BUILT A LARGE MOUND OF STONE
AROUND IT. I BURIED STONE MUN. BESIDE PIPE.
I SET A STEEL POST 3' S. OF CORNER W/SIGN 54-4
I PAINTED A RED BAND AROUND BOTH BT'S, AND TAGGED THEM W/SIGN 54-3

REGISTERED
PROFESSIONAL
LAND SURVEYOR

Victor M. McLind

OREGON
JULY 17, 1970
VICTOR M. MCLIND
934

I HEREBY CERTIFY THE ABOVE CORNER MONUMENT
WAS RE-ESTABLISHED AS HEREIN DESCRIBED ON
MAY 27, 1980.

WITNESS: *Doug McLind*

Office of..... County of.....
State of....., I hereby certify that the within instrument was filed in this office
for record on the..... day of....., 19.....
..... by

(COUNTY OFFICIAL)

(DEPUTY)

Doug McLind