


CERTIFIED RECORD OF LAND CORNER MONUMENTATION

History of original corner establishment: ESTABLISHED IN 1880 BY  
W. B. BARR UNDER G. L. O. CONTRACT NO. 358  
SURVEYOR GENERAL'S RECORDS STATE:  
MARKED BASALT ROCK 16x10x6 FOR CORNER  
TO SEC. 9x10x15x16, RAISED MOUND OF ROCKS  
AS PER INSTRUCTIONS.

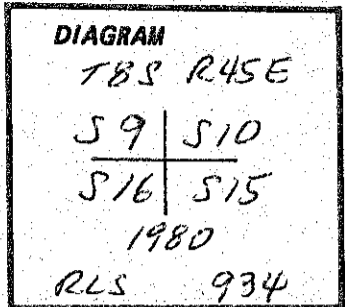

Description of corner evidence found: FND. BASALT ROCK 16"x10"x6" WITH 4 NOTCHES ON  
S, AND 3 NOTCHES ON E. EDGES, IN MOUND OF STONE. LIES APPROX. 2 1/2  
CHAINS E. OF SPUR, COURSE S 45°W, AS PER NOTES.

Description of monument and accessories I established to perpetuate the  
original location of this corner: IN PLACE OF ROCK MON. I SET A 2"x30" GALV. IRON PIPE  
W/BRASS CAP STAMPED AS SHOWN ABOVE, FROM WHICH:  
NEW BEARING OBJECT, BOULDER, 27"x38"x19" HIGH, CHISELED "BO+", BEARS  
N 63°W, 56.9 FT. TO FACE.  
NEW BEARING OBJECT, BOULDER 26"x28"x18" HIGH, CHISELED "BO+", BEARS  
N 55°E, 91.7 FT. TO FACE.  
NEW BEARING OBJECT, BOULDER 23"x24"x14" HIGH, CHISELED "BO+", BEARS  
S 58°W, 94.3 FT. TO FACE.  
NEW BEARING OBJECT, BOULDER 15"x25"x20" HIGH, CHISELED "BO+", BEARS  
S 48 3/4°E, 88.4 FT. TO FACE.  
I SET THE 2" PIPE 27" IN GROUND, BURIED STONE MON. ALONGSIDE, AND SET STONES AROUND IT.  
I SET A STEEL POST 3' S. OF COR. W/SIGN S4-4

REGISTERED  
PROFESSIONAL  
LAND SURVEYOR

*Victor M. McFid*

OREGON  
JULY 17, 1970  
VICTOR M. MCLIND  
934

I HEREBY CERTIFY THE ABOVE CORNER MONUMENT WAS  
RE-ESTABLISHED AS HEREIN DESCRIBED ON  
MAY 27, 1980

WITNESS: *Doug McFid*

Office of..... County of.....  
State of..... I hereby certify that the within instrument was filed in this office  
for record on the..... day of....., 19.....  
..... by .....

(COUNTY OFFICIAL)

(DEPUTY)