


CERTIFIED RECORD OF LAND CORNER MONUMENTATION

History of original corner establishment: *CORNER ESTABLISHED IN 1873 BY BARRIN & WALDEN UNDER G.L.O. CONTRACT.*

SURVEYOR GENERAL'S RECORDS STATE:

*SET BASALT ROCK 12x12x5 6IN IN GROUND FOR 1/4 SEC. COR.*

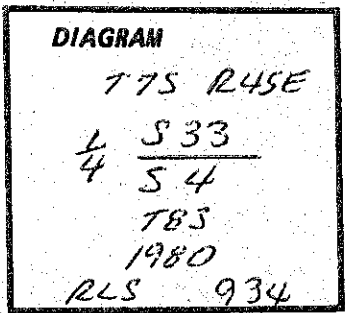

Description of corner evidence found: *NONE*

Description of monument and accessories I established to perpetuate the original location of this corner:

*AT PROPORTIONED LOCATION I SET A 2" x 30" GALV. IRON PIPE W/ BRASS CAP STAMPED AS SHOWN ABOVE, FROM WHICH:*

*NEW BT, 10" PINE, SCRIBED "1/4 S 4 BT" BEARS S 57° E 19.7 FT.*

*NEW BT, 14" PINE, SCRIBED "1/4 S 33 BT" BEARS N 43° E 44.4 FT.*

*I SET THE 2" PIPE 18" IN GROUND AND BUILT A STONE MOUND AROUND IT.*

*I SET A STEEL POST 3' E. OF COR. W/SIGN 54-4*

*I PAINTED A RED BAND AROUND BOTH BT'S, AND TAGGED THEM W/SIGN 54-3.*

REGISTERED  
PROFESSIONAL  
LAND SURVEYOR

*Victor M. McLind*

OREGON  
JULY 17, 1970  
VICTOR M. McLIND  
934

*I HEREBY CERTIFY THE ABOVE CORNER MONUMENT WAS RE-ESTABLISHED AS HEREIN DESCRIBED ON JUNE 20, 1980.*

WITNESS: *Doug McLind*

Office of..... County of.....

State of....., I hereby certify that the within instrument was filed in this office

for record on the..... day of....., 19.....

..... by .....  
(COUNTY OFFICIAL) (DEPUTY)

*Doug*