


CERTIFIED RECORD OF LAND CORNER MONUMENTATION

History of original corner establishment: CORNER ESTABLISHED IN 1873 BY BARIN & WALDEN, UNDER G.L.O. CONTRACT. SURVEYOR GENERAL'S RECORDS STATE: SET BASALT ROCK 7x8x14. 8 IN. IN GROUND FOR CORNER TO SEC. 33, 34, 3, 4

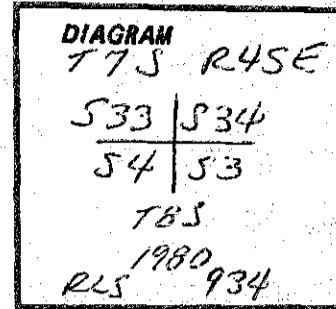

Description of corner evidence found: NONE

Description of monument and accessories I established to perpetuate the original location of this corner: AT PROPORTIONED LOCATION I SET A 2" x 30" GALV. IRON PIPE W/ BRASS CAP STAMPED AS SHOWN ABOVE, FROM WHICH:  
NEW BT, 8" FIR, SCRIBED "T8S R45E S3 BT" BEARS S 58 1/2° E 44.4 FT.  
NEW BT, 6" FIR, SCRIBED "T8S R45E S4 BT" BEARS S 54° W, 41.9 FT.  
NEW BT, 9" FIR, SCRIBED "T7S R45E S34 BT" BEARS N 47 1/4° E, 29.0 FT.  
NEW BT, 8" FIR, SCRIBED "T7S R45E S33 BT" BEARS N 55° W, 53.3 FT.

I SET THE 2" PIPE 28" IN GROUND AND SET STONES AROUND IT.  
I SET A STEEL POST 3' N. OF COR. W/SIGN 54-2 & 54-4 AND A STEEL POST 3' E. OF COR. W/SIGN 54-2.  
I PAINTED A RED BAND AROUND ALL BT'S, AND TAGGED THEM W/SIGN 54-3

REGISTERED PROFESSIONAL LAND SURVEYOR  
VICTOR M. McLIND  
OREGON JULY 17, 1970 VICTOR M. McLIND 934

I HEREBY CERTIFY THE ABOVE MONUMENT WAS RE-ESTABLISHED AS HEREIN DESCRIBED ON JUNE 10, 1980.

WITNESS: Doug McFird

Office of..... County of.....  
State of..... I hereby certify that the within instrument was filed in this office for record on the..... day of....., 19.....  
..... by .....  
(COUNTY OFFICIAL) (DEPUTY)