


CERTIFIED RECORD OF LAND CORNER MONUMENTATION

History of original corner establishment: CORNER ESTABLISHED IN 1873  
BY BARIN AND WALDEN BY G.L.O. CONTRACT  
SURVEYOR GENERAL'S RECORDS STATE:  
SET BASALT ROCK 18" X 10" X 5", 8" IN GROUND FOR  
1/4 SEC. COR.

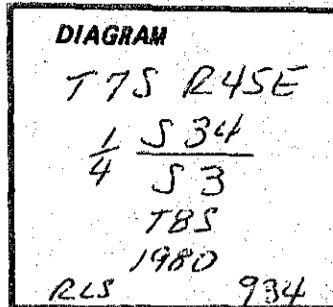

Description of corner evidence found: NONE

Description of monument and accessories I established to perpetuate the original location of this corner: AT PROPORTIONED LOCATION I SET A 2" X 30" GALV. IRON PIPE W/ BRASS CAP STAMPED AS SHOWN ABOVE, FROM WHICH:  
NEW BT, 10" PINE, SCRIBED "1/4 S 3 BT" BEARS S 63 1/2° E, 31.4 FT.  
NEW BT, 16" FIR, SCRIBED "1/4 S 34 BT" BEARS N 39° W, 5.9 FT.

I SET THE 2" PIPE 28" IN GROUND AND SET STONES AROUND IT.  
I SET A STEEL POST 3' S. OF COR. W/ SIGNS 54-2 & 54-4.  
I PAINTED BOTH BT'S WITH A RED BAND, AND TAGGED THEM W/ SIGN 54-3

REGISTERED  
PROFESSIONAL  
LAND SURVEYOR  
*Victor M. McLind*  
OREGON  
JULY 17, 1970  
VICTOR M. McLIND  
934

I HEREBY CERTIFY THE ABOVE CORNER MONUMENT WAS RE-ESTABLISHED AS HEREIN DESCRIBED ON JUNE 10, 1980.

WITNESS: *Doug McLind*

Office of..... County of.....  
State of....., I hereby certify that the within instrument was filed in this office for record on the..... day of....., 19.....  
..... by .....

(COUNTY OFFICIAL)

(DEPUTY)

Form R6-7100-57 (9/71)

FILED Aug 11, 1980  
BAKER COUNTY SURVEYOR  
SURVEY NO. 7-45-62  
8-45-42

☆ GPO-798-276

*Doug*