


CERTIFIED RECORD OF LAND CORNER MONUMENTATION

History of original corner establishment: *NONE*

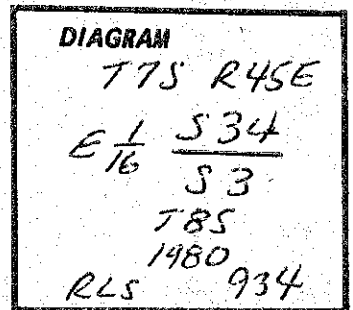

Description of corner evidence found: *NONE*

Description of monument and accessories I established to perpetuate the original location of this corner: *AT PROPORTIONED POSITION I SET A 2" x 30" GALV. IRON PIPE W/ BRASS CAP STAMPED AS SHOWN ABOVE, FROM WHICH:*
NEW BT, 8" PINE, SCRIBED "E $\frac{1}{16}$ S 3 BT" BEARS S 51 $\frac{1}{2}$ ° E, 60.3 FT.
NEW BT, 11" FIR, SCRIBED "E $\frac{1}{16}$ S 34 BT" BEARS N 10 $\frac{1}{2}$ ° E, 20.1 FT.

I SET THE 2" PIPE 27" IN GROUND AND SET STONES AROUND IT.
I SET A STEEL POST 3' E. OF COR. W/ SIGNS 54-2 & 54-9.
I PAINTED A RED BAND AROUND BOTH BT'S, AND TAGGED THEM W/ SIGN 54-3.

REGISTERED
 PROFESSIONAL
 LAND SURVEYOR

Victor M. McLind

OREGON
 JULY 17, 1970
 VICTOR M. McLIND
 934

I HEREBY CERTIFY THE ABOVE CORNER MONUMENT WAS ESTABLISHED AS HEREIN DESCRIBED ON JUNE 11, 1980.

WITNESS: *Doug McFid*

Office of..... County of.....
 State of..... I hereby certify that the within instrument was filed in this office
 for record on the..... day of....., 19.....
 by
 (COUNTY OFFICIAL) (DEPUTY)

Doug