


CERTIFIED RECORD OF LAND CORNER MONUMENTATION

History of original corner establishment: *NONE*

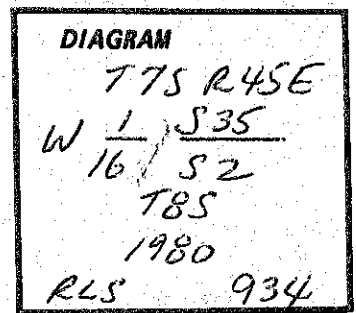

Description of corner evidence found: *NONE*

Description of monument and accessories I established to perpetuate the original location of this corner: *AT CALCULATED POSITION I SET A 2" x 30" GALV. IRON PIPE W/ BRASS CAP STAMPED AS SHOWN ABOVE, FROM WHICH:*
NEW BT, 12" FIR, SCRIBED "W $\frac{1}{16}$ S 35 BT" BEARS N 07° W, 4.7 FT.
NEW BT, 9" FIR, SCRIBED "W $\frac{1}{16}$ S 2 BT" BEARS S 48 $\frac{1}{2}$ ° E, 29.4 FT.

I SET THE 2" PIPE 26" IN GROUND AND SET STONES AROUND IT.
I SET A STEEL POST 3' W. OF COR. W/SIGNS 54-2 & 54-9.
I PAINTED A RED BAND AROUND BOTH BT'S, AND TAGGED THEM W/SIGN 54-3.

REGISTERED
PROFESSIONAL
LAND SURVEYOR

Victor M. McLeod

OREGON
JULY 17, 1970
VICTOR M. McLIND
934

I HEREBY CERTIFY THE ABOVE CORNER MONUMENT WAS ESTABLISHED AS HEREIN DESCRIBED ON JUNE 13, 1980.

WITNESS: *Doug McLeod*

Office of..... County of.....
 State of....., I hereby certify that the within instrument was filed in this office
 for record on the..... day of....., 19.....
 by
 (COUNTY OFFICIAL) (DEPUTY)

Form R6-7100-57 (9/71)

FILED Aug 11, 1980
 BAKER COUNTY SURVEYOR
 SURVEY NO. 7-45-65
8-45-45

Doug