


CERTIFIED RECORD OF LAND CORNER MONUMENTATION

History of original corner establishment: ESTABLISHED IN 1873 BY
BARIN AND WALDEN UNDER G.L.D. CONTRACT
SURVEYOR GENERAL'S RECORDS STATE:
SET BASALT ROCK 16x12x5 8 IN. IN GROUND
FOR 1/4 SEC. CORNER

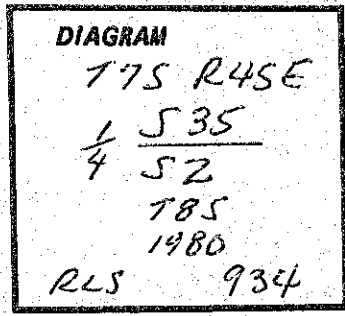

Description of corner evidence found: NONE

Description of monument and accessories I established to perpetuate the
original location of this corner: AT PROPORTIONED POSITION I SET A 2"x30" GALV.
IRON PIPE W/ BRASS CAP STAMPED AS SHOWN ABOVE, FROM WHICH:
NEW BT, 9" PINE, SCRIBED "1/4 S 2 BT" BEARS S 19° W, 25.7 FT.
NEW BT, 13" PINE, SCRIBED "1/4 S 35 BT" BEARS N 14° W, 56.6 FT.
I SET THE 2" PIPE 28" IN GROUND AND SET STONES AROUND IT.
I SET A STEEL POST 3' E. OF COR. W/ SIGN 54-4
I PAINTED A RED BAND AROUND BOTH BT'S, AND TAGGED THEM W/ SIGN 54-3

REGISTERED
PROFESSIONAL
LAND SURVEYOR

Victor M. McInd

OREGON
JULY 17, 1970
VICTOR M. McLIND
934

I HEREBY CERTIFY THE ABOVE CORNER MONUMENT WAS
RE-ESTABLISHED AS HEREIN DESCRIBED ON
JUNE 13, 1980.

WITNESS: *Doug McInd*

Office of..... County of.....
State of..... I hereby certify that the within instrument was filed in this office
for record on the..... day of....., 19.....
..... by

(COUNTY OFFICIAL)

(DEPUTY)

Doug