


CERTIFIED RECORD OF LAND CORNER MONUMENTATION

History of original corner establishment:

Corner was established in 1880 under Contract No. 355, by W.B. Barr. At the $\frac{1}{4}$ corner common to Sections 17 & 18, T 8 S, R 45 E, he set a marked basalt rock 10 x 10 x 6 for the $\frac{1}{4}$ cor. and made a raised mound of rocks as per instructions.

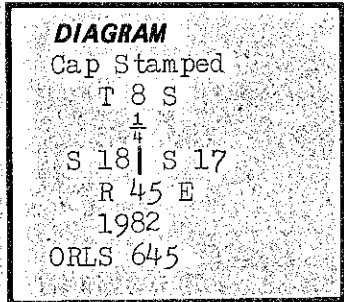

Description of corner evidence found:

At the above mentioned $\frac{1}{4}$ corner location I made an extensive search and found no evidence of the original corner. Terrain is very steep with large ledge outcrops and rocky slopes making it virtually impossible to locate the original monument.

Description of monument and accessories I established to perpetuate the original location of this corner:

After an extensive search of the area and finding no trace of the original corner I then determined I must establish the $\frac{1}{4}$ corner by perportionate measurements between the found section corners both to the north and south of the corner location. Using a solar bearing, I determined the line common to Section 17 & 18, to bear N 02 56 15 W a distance of 5102.83 feet. I then set the $\frac{1}{4}$ corner common to Sec's. 17 & 18, T 8 S R 45 E at the mid point along said line, being a brass cap on a 30" galv. iron pipe in a mound of stone approximately 5 feet north of a large ledge rock on a very steep easterly slope. Cap being stamped as shown above.

REGISTERED
PROFESSIONAL
LAND SURVEYOR

James H. Hambleton
5-17-82

OREGON
JULY 16 1944
JAMES H. HAMBLETON
643

Office of..... County of.....
State of..... I hereby certify that the within instrument was filed in this office
for record on the..... day of....., 19.....
..... by
(COUNTY OFFICIAL) (DEPUTY)