


**CERTIFIED RECORD OF LAND CORNER MONUMENTATION**

0959

**History of original corner establishment:**

The original survey was done by W.B. Barr under Contract No. 355 dated June 14, 1880

Marked basalt rock 15 X 15 X 6 for corner to sec. 8X9X16X17 Raised mound of rocks as per instructions.

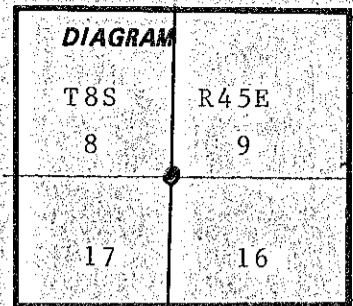

**Description of corner evidence found:**

At the corner I found a rock 15"X15"X6" in a mound of rock with 4 notches on the South edge and 4 notches on the East edge. No accessories were set.


**Description of monument and accessories I established to perpetuate the original location of this corner:**

I replaced the basalt rock with a 2½" X 32" brass capped steel pipe 6" in the ground in a mound of rock 3' X 24". I buried the original rock in the mound face down on the East side of the pipe. I set no accessories.

**As Witnesses;**

Glen A. Weideman L.S. 626  
Susan Bleeg Survey tech.

**Monument stamped:**

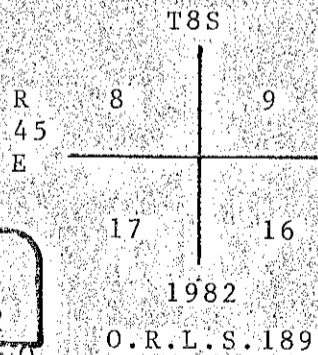

Office of..... County of.....  
 State of..... I hereby certify that the within instrument was filed in this office  
 for record on the..... day of....., 19.....  
 ..... by .....  
 (COUNTY OFFICIAL) (DEPUTY)