


CERTIFIED RECORD OF LAND CORNER MONUMENTATION

0559

History of original corner establishment:

Original corner set by W.B. Barr under Contract No. 355 dated June 14, 1880. Marked basalt rock 30" X 24" X 29" for corner to sec. 7 X 8 X 17 X 18 raised mound of rocks as per instructions from which Pine 20" diam bears N78°W 35 links distance

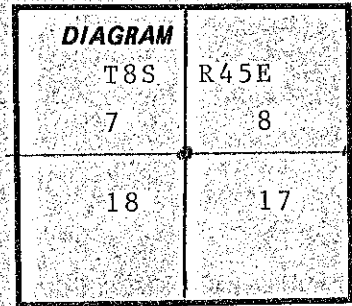


In 1980 James H. Hambleton located the corner and replaced the rock with a 2" X 30" brass capped steel pipe in a large mound of stone.

Description of corner evidence found:

At the corner I found James H. Hambleton's brass cap as described. I also found the bearing tree as set by W.B. Barr. It has a fence wire attached and is hard to tell if it was scribed.

Monument stamped:

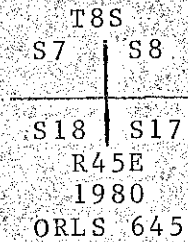

Description of monument and accessories established to perpetuate the original location of this corner:

- I set 4 additional bearing trees or objects.
- A 20" Ponderosa Pine bears N61°45'W 64.10 ft. marked T8S R45E S7 BT Nail in N. base.
- An 18" Ponderosa Pine bears S65°45'W 138.62 ft. marked T8S R45E S18 BT Nail in N. base.
- A 22" Ponderosa Pine bears S55°30'E 113.83 ft. marked T8S R45E S17 BT Nail in E. base.
- A 5½' X 4' X 2' basalt rock bears N25°E 38.58 ft. marked "X" BO chiseled on top. Distance pulled to "X".

Bearings taken with a staff compass declination 18½° East per 1980 Isogonic chart.

Distances pulled to 60d nail with brass washer stamped L.S.1898 driven in side center of bearing trees.

17-June 1982

**REGISTERED
PROFESSIONAL
LAND SURVEYOR**

Harry C. Hildebrand

**OREGON
JULY 13, 1980
HARRY C. HILDEBRAND
1898**

Office of..... County of.....
 State of..... I hereby certify that the within instrument was filed in this office
 for record on the..... day of....., 19.....
 by
 (COUNTY OFFICIAL) (DEPUTY)

Form R6-7100-57 (9/71)

FILED June 22, 1982
 BAKER COUNTY SURVEYOR
 SURVEY NO. 8-45-S1

☆ GPO—798-276

J- 05