

CERTIFIED RECORD OF LAND CORNER MONUMENTATION

History of original corner establishment:

Corner originally established by Walden under contract #198 dated July 1873

Set Basalt rock 16" x 8" x 6" 8" in ground

DIAGRAM

T8S  
R44E R45E

1/4  
12 | 7

Description of corner evidence found:

No evidence of original stone  
Set by single proportionate measurement

Description of monument and accessories established to perpetuate the original location of this corner:

Set 2 1/2" x 30" aluminum pipe with 3/4" aluminum cap 22" in ground in mound of stone, marked:



Bearing trees:

13" ponderosa pine - N50 1/2° W - 109.3 ft. scribed "1/4 S12" in upper blaze and "BT" and brass tag stamped RLS 1664 in lower blaze  
17" ponderosa pine - N86° E - 137.2 ft. scribed "1/4 S7" in upper blaze and "BT" and brass tag stamped RLS 1664 in lower blaze


Compass declination 19 3/4° East

Note:


I set steel fence post 6' south with USFS 54-4 sign, placed USFS bearing tree and attention signs on all bearing trees and painted red band at breast height on smoothed bark on all bearing trees.

I hereby certify the above corner was perpetuated as herein described in June 1983.

Witness: Ron Horton

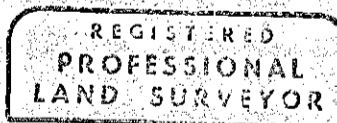

*Carl E. Sundet*

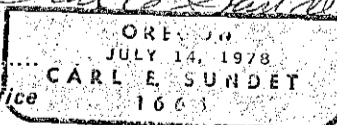

Office of..... County of.....  
State of....., I hereby certify that the within instrument was filed in this office  
for record on the..... day of....., 19.....

(COUNTY OFFICIAL)

(DEPUTY)

Form R6-7100-57 (9/71)

☆ GPO-798-278

FILED July 25 1983  
BAKER COUNTY SURVEYOR  
SURVEY NO. 8-44-60  
8-45-54