


CERTIFIED RECORD OF LAND CORNER MONUMENTATION

History of original corner establishment:

Corner originally established by Walden under contract #198 dated July 1873.

Set basalt stone 14" x 10" x 5" 8" in ground

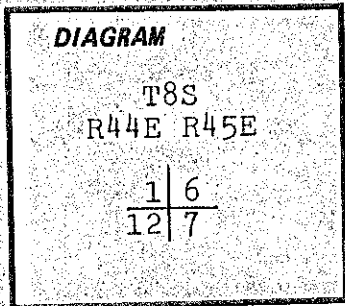


Description of corner evidence found:

No evidence of original stone.
Set by single proportionate measurement.

Description of monument and accessories established to perpetuate the original location of this corner:

Set 2½" x 30" aluminum pipe with ¾" aluminum cap 20" in ground in mound of stone, marked:

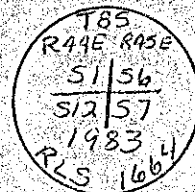

Bearing trees:

- 9" douglas fir - N0½°W - 9.4 ft. scribed "T8SR44E S1" in upper blaze and "BT" and brass tag stamped RLS 1664 in lower blaze
- 7" douglas fir - S45°W - 13.3 ft. scribed "T8SR44E S12" in upper blaze and "BT" and brass tag stamped RLS 1664 in lower blaze
- 6" douglas fir - S52°E - 2.9 ft. scribed "T8SR45E S7" in upper blaze and "BT" and brass tag stamped RLS 1664 in lower blaze
- 6" douglas fir - N71°E - 18.2 ft. scribed "T8SR45E S6" in upper blaze and "BT" and brass tag stamped RLS 1664 in lower blaze

Compass declination 19 ¾° East

Note:

I set steel fence post 6' west of corner with USFS 54-4 sign, placed USFS bearing tree and attention signs on all bearing trees and painted red band at breast height on smoothed bark on all bearing trees.

I hereby certify the above corner was perpetuated as herein described in June 1983

Witness: Ron Horton

REGISTERED PROFESSIONAL LAND SURVEYOR

<i>Carl E. Sundet</i>
OREGON JULY 14, 1978 CARL E. SUNDET 1664

Office of..... County of.....
State of..... I hereby certify that the within instrument was filed in this office
for record on the..... day of....., 19.....

(COUNTY OFFICIAL)

(DEPUTY)

Form R6-7100-57 (9/71)

FILED July 25 1983
 BAKER COUNTY SURVEYOR
 SURVEY NO. 8-44-62
8-45-55