


CERTIFIED RECORD OF LAND CORNER MONUMENTATION

History of original corner establishment:

Not previously established.

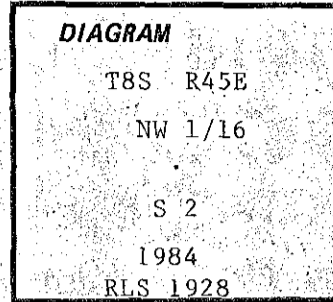

Description of corner evidence found:

Not previously established.

Description of monument and accessories established to perpetuate the original location of this corner:

Set 30" long aluminum pipe with 3 1/2" aluminum cap marked as shown above, 14" above ground mounded with rock. Steel post with signs 54-9 & 54-2 set next to cap.

Scribed:

- 10" fir N.75°E. 16.4' "NW 1/16 S2 BT"
- 12" fir S.28°W. 22.7' "NW 1/16 S2 BT"

Attached signs 54-3 & 54-9 and nailed aluminum washers stamped "RLS 1928" by "BT" scribe on each tree. Painted blazes red and a 6" red band around both trees.

REGISTERED
PROFESSIONAL
LAND SURVEYOR
1-20-86
Duane Fehring
OREGON
JULY 13, 1984
DUANE FEHRINGER
2118

Office of..... County of.....
State of....., I hereby certify that the within instrument was filed in this office
for record on the..... day of....., 19.....

..... by
(COUNTY OFFICIAL) (DEPUTY)

FILED *May 9 1986*
BAKER COUNTY SURVEYOR
SURVEY NO. *8-45-62*