


CERTIFIED RECORD OF LAND CORNER MONUMENTATION

History of original corner establishment:

Not previously established.

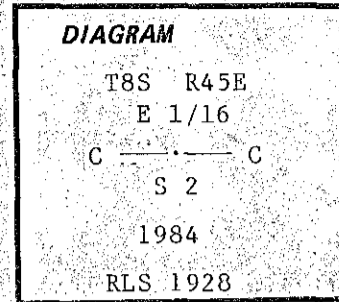

Description of corner evidence found:

Not previously established.

Description of monument and accessories established to perpetuate the original location of this corner:

Set 30" long aluminum pipe with 3 1/2" aluminum cap, marked as shown above, 18" above ground, mounded with rock. Steel post with signs 54-9 & 54-2 set next to cap.

Scribed:

- 12" pine S.54°W. 62.8' "C E 1/16 S2 BT"
- 10" pine S.01°W. 54.4' "C E 1/16 S2 BT"

Attached signs 54-3 & 54-9 and nailed aluminum washers stamped "RLS 1928" by "BT" scribe on each tree. Painted blazes red and a 6" red band around both trees.

REGISTERED
 PROFESSIONAL
 LAND SURVEYOR

1-20-86
Duane Fehring

OREGON
 JULY 13, 1984
 DUANE FEHRINGER
 2118

Office of..... County of.....
 State of..... I hereby certify that the within instrument was filed in this office
 for record on the..... day of....., 19.....
 by.....
 (COUNTY OFFICIAL) (DEPUTY)

FILED *May 9 1986*
 BAKER COUNTY SURVEYOR
 SURVEY NO. *8-45-65*