


CERTIFIED RECORD OF LAND CORNER MONUMENTATION

History of original corner establishment:

Not previously established.

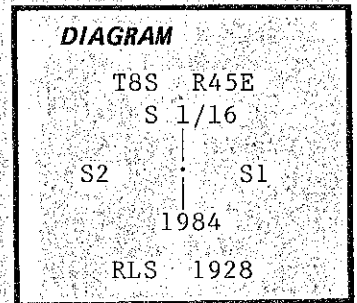

Description of corner evidence found:

Not previously established.

Description of monument and accessories | established to perpetuate the original location of this corner:

Set 30" long aluminum pipe with 3/4" aluminum cap, marked as shown above, 6" above ground. Steel post with signs 54-9 & 54-2 set next to cap.

Scribed:

- 10" pine N.08°E. 28.5' "S 1/16 S1 BT"
- 7" pine N.60°W. 27.9' "S 1/16 S2 BT"

Attached signs 54-3 & 54-9 and nailed aluminum washers stamped "RLS 1928" by "BT" scribe on each tree. Painted blazes red and a 6" red band around both trees.

REGISTERED
PROFESSIONAL
LAND SURVEYOR
1-20-86
Duane Fehringer
OREGON
JULY 13, 1984
DUANE FEHRINGER
2118

Office of..... County of.....
State of....., I hereby certify that the within instrument was filed in this office
for record on the..... day of....., 19.....

(COUNTY OFFICIAL)

(DEPUTY)

FILED May 9, 1986
BAKER COUNTY SURVEYOR
SURVEY NO. 8-45-69