


CERTIFIED RECORD OF LAND CORNER MONUMENTATION

History of original corner establishment:

Original exterior boundary line survey executed by N. O. Walden in October 1873 under Contract No. 198, dated July 15, 1873. Original subdivisional survey executed by W. B. Barr in September 1880 under contract No. 355, dated June 14, 1880.

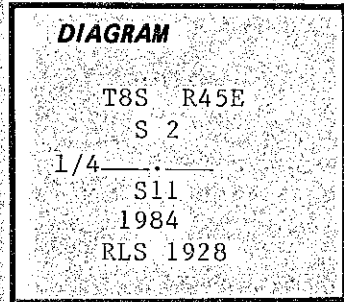

Set basalt rock 12"x12"x10" in mound of rock.

Description of corner evidence found:

NONE

Description of monument and accessories established to perpetuate the original location of this corner:

Set 30" long aluminum pipe with 3 1/4" aluminum cap, marked as shown above, 6" above ground. Steel post with sign 54-9 set next to cap.

Scribed:

- 15" pine S20E 29.0' "1/4 S11 BT"
- 12" fir N10W 24.0' "1/4 S2 BT"

Attached signs 54-3 & 54-9 and nailed aluminum washers stamped "RLS 1928" by "BT" scribe on each tree. Painted blazes red and a 6" red band around both trees.

REGISTERED  
PROFESSIONAL  
LAND SURVEYOR  
1-20-86  
*Duane Fehring*  
OREGON  
JULY 13, 1984  
DUANE FEHRINGER  
2118

Office of..... County of.....  
State of..... I hereby certify that the within instrument was filed in this office  
for record on the..... day of....., 19.....  
..... by .....

(COUNTY OFFICIAL) (DEPUTY)