


CERTIFIED RECORD OF LAND CORNER MONUMENTATION

History of original corner establishment:

(Original GLO in 1881 by W. Barr, set basalt stone 24"x18"x15" in rock mound.)

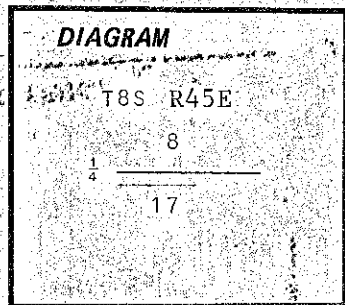

Description of corner evidence found:

None, Corner falls on a very steep Westerly slope and I can only assume that the original stone rolled down the steep hill.

Description of monument and accessories established to perpetuate the original location of this corner: Thus at the single proportion position I:

Set 2"x30" alum. pipe with 3/4" alum. cap 25" in the ground and in a mound of stone.


Set 5/8"x30" iron rod set 26" in the ground in a mound of stone with alum cap, N16°01'E, 10.0', mkd., "RM $\xrightarrow{10.0}$ "

20" P.P. S85°28'E, 131.9', mkd., "1/4 S 17 BT".

Set 6' steel post with signs 54-9 and 54-2, 5'W and 4'E.

Each BT has red painted band and face and brass LS washer and 54-9 and 54-3 signs.

Witnessed by P. Leigh.

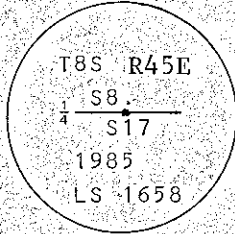

**REGISTERED
 PROFESSIONAL
 LAND SURVEYOR**

4-30-86
Ronald N. Scholson

OREGON
 JULY 14, 1978
RONALD H. SCHULSON
 1658

Office of..... County of..... Baker.....

State of..... I hereby certify that the within instrument was filed in this office

for record on the..... day of..... 19.....

..... by..... (COUNTY OFFICIAL) (DEPUTY)

FILED June 16, 1986
 BAKER COUNTY SURVEYOR
 SURVEY NO. 8-45-73