

CERTIFIED RECORD OF LAND CORNER MONUMENTATION

E-5


History of original corner establishment:

Corner established by W.B. Barr under GLO contract no. 358 dated June 14, 1880.

Surveyor General records state:
 Marked basalt rock 24 x 18 x 5" for corner sec 5 x 6 x 17 x 18.
 Raised mound of rocks as per instructions.

Corner REMONUMENTED by Victor M. McLind, see Baker County Survey No. 8-45-27... Found basalt rock 24"x18"x5" with mound of rock alongside, in old N-S fence line. No marks could be found on rock. Fits Barr's call to canyon which lies North 5.50 chains. In place of found rock I set a 2"x30" galv. iron pipe with brass cap stamped as shown above, from which: New BT, 9" fir scribed T8SR45ES6BT bears N11°W, 209.1'. New BT, 11" pine scribed T8SR45ES5BT bears N28½°E, 132.9'. New BT, 18" pine scribed T8SR45ES8BT bears S78°E, 318.0'. New BT, 15" fir scribed T8SR45ES7BT bears S72°W, 204.0'. I set the 2" pipe 18" in ground and built a large mound of stone around it. I set a steel post 3' S of corner with sign 54-4. I buried orig stone alongside 2" pipe. Painted red band around

Description of corner evidence found: all BT's and tagged them with sign 54-3.

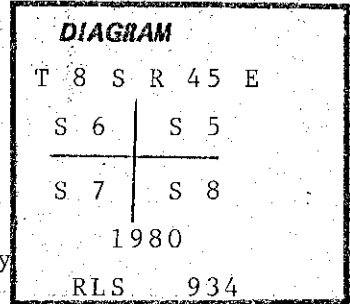

Found 2½" brass cap on 2" iron pipe projecting 6" out of surrounding rock mound and fence post alongside with sign 54-4 attached.

- A fir 16" diam brs S72°W, 204.0' dist with full record scribes and brass washer on partially healed blaze and sign 54-3 by V. McLind dated 6-25-80.
- A fir 10" diam brs N11°W, 209.1' dist with full record scribes and brass washer on partially healed blaze and sign 54-3 by V. McLind dated 6-25-80.
- A p pine 11" diam brs N28½°E, 132.9' dist with full record scribes and brass washer on partially healed blaze and sign 54-3 by V. McLind, 6-25-80.
- A p pine 20" diam brs S78°E, 318.0' dist with full record scribes and brass washer on partially healed blaze by V. McLind dated 6-25-80.

Description of monument and accessories I established to perpetuate the original location of this corner:

MAINTAINED corner by improving surrounding rock mound, firmly setting fence post to which sign 54-4 replaced with sign 54-9 and repainted blaze and surrounding band with red paint and attached sign 54-9 to back of all BT's.

Compass declination 20° East.

I hereby certify that the above described corner monument was properly maintained by me on March 13, 1987.

**REGISTERED
PROFESSIONAL
LAND SURVEYOR**

William L. Hanley

**OREGON
JULY 14, 1978
WILLIAM L. HANLEY
1639**

Office of... County Surveyor..... County of... Baker.....
 State of... Oregon....., I hereby certify that the within instrument was filed in this office
 for record on the..... day of....., 19.....
 by
 (COUNTY OFFICIAL) (DEPUTY)

FILED 4/15/87
 BAKER COUNTY SURVEYOR
 SURVEY NO. 8/45/75