

CERTIFIED RECORD OF LAND CORNER MONUMENTATION

J-13

History of original corner establishment:

Corner established by W.B. Barr under GLO contract no. 358 dated June 14, 1880.

Surveyor General records state:


Marked basalt rock 16x10x6" for cor to secs 9,10,15&16. Raised mound of rocks as per instructions.

Corner REMONUMENTED by V. McLind, ORLS 934, in 1980... Baker County Survey records state... Found basalt rock 16

x 10 x 6" with 4 notches on S and 3 notches on E edges in mound of stone. In place of rock mon. I set a 2 x 30" galv iron pipe with brass cap stamped as shown above. I set the 2" pipe 27" in ground buried stone mon alongside and set stones around pipe. I set a steel post 3' S of corner with sign 54-4. New Bearing Object, boulder 27 x 38 x 19" high chisled "BO+" bears N63°W, 56.9' to face. New B.O. boulder 23 x 24 x 18" high chisled "BO+" bears S58°W, 94.3'. New B.O. boulder 26 x 28 x 18" chisled "BO+" bears N55°E, 19.7' to face. New B.O. boulder 15 x 25 x 20" high chisled "BO+" bears S483/4°E, 88.4' to face.

Description of corner evidence found:

Found: A 2 1/2" brass cap on 2" iron pipe projecting 4" out of ground with small surrounding rock mound and steel fence post 3' North and South with damaged signs 54-4. Also found bearing objects established by McLind to be marked and located as he described in Baker County Survey. (above).

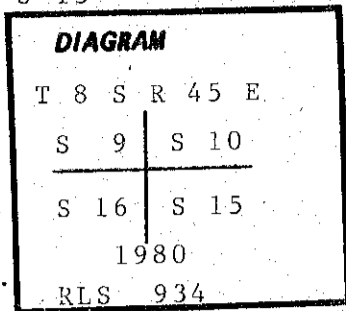

Description of monument and accessories I established to perpetuate the original location of this corner:

MAINTAINED corner monument by improving surrounding rock mound, attaching signs 54-9 in place of damaged signs 54-4 and by painting bearing objects with red paint.

Compass declination 20° East.

I hereby certify that the above described corner monument was properly maintained by me on March 31, 1987.

REGISTERED
PROFESSIONAL
LAND SURVEYOR

William L. Hanley

OREGON
JULY 14, 1978
WILLIAM L. HANLEY
1639

Office of... County Surveyor..... County of... Baker
State of... Oregon....., I hereby certify that the within instrument was filed in this office
for record on the..... day of....., 19.....

..... by
(COUNTY OFFICIAL) (DEPUTY)

FILED 4/15/87
BAKER COUNTY SURVEYOR
SURVEY NO. 845/26