


**CERTIFIED RECORD OF LAND CORNER MONUMENTATION**

L-5

**History of original corner establishment:**

Corner established by W.B.Barr under GLO contract no. 358 dated June 14, 1880.

Surveyor General records state:  
Marked basalt rock 10 x 10 x 6" for 1/4 sec corner.  
Raised mound of rocks as per instructions:

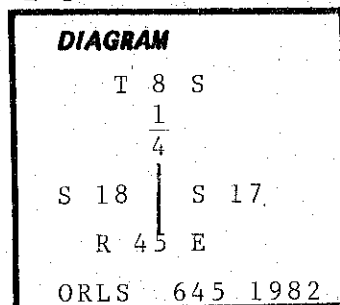

Corner REESTABLISHED by James Hambleton, ORLS 645, in 1982 and recorded in Baker County Survey No 8-45-47... After an extensive search of the area and finding no trace of the original corner I then determined I must establish the 1/4 corner by perportionate measurements between the found section corners both to the north and South of the corner location. Using a solar bearing I determined the line common to Sec 17 & 18 to bear N02°56'15"W, 5102.83'. I then set the 1/4 corner common to Sec's 17 & 18, T8SR45E at the mid point along said line, being a brass cap on a 30" galv iron pipe in a mound of stone approximately 5' north

**Description of corner evidence found:** of a large ledge rock on very steep easterly slope. Cap being stamped as shown above.

Found: 2 1/2" brass cap on 1 1/2" iron pipe projecting 8" out of the ground and surrounding rock mound with a steel fence post alongside.


**Description of monument and accessories I established to perpetuate the original location of this corner:**

MAINTAINED corner monument by improving surrounding rock mound, placing a sign 54-9 on steel fence post alongside and marking the following bearing objects, there being no reasonably accessible trees available.

A basalt boulder 63" x 28" and projecting 15" above ground brs N47°E, 22.6' dist marked "BXO" on its West face.  
A basalt boulder 36" x 32" and projecting 24" above ground brs S01°W, 24.5' dist marked "BXO" on its West top.

Compass declination 20° East.

I hereby certify that the above described corner monument was properly maintained by me on March 31, 1987.

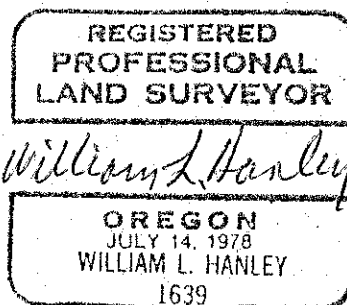

Office of... County Surveyor..... County of... Baker  
State of... Oregon....., I hereby certify that the within instrument was filed in this office  
for record on the..... day of....., 19.....  
..... by .....  
(COUNTY OFFICIAL) (DEPUTY)

FILED 4/13/87  
BAKER COUNTY SURVEYOR  
SURVEY NO. 8415/77