

CERTIFIED RECORD OF LAND CORNER MONUMENTATION


L-13

History of original corner establishment:

Corner established by W.B. Barr under GLO contract no. 358 dated June 14, 1880.

Surveyor General records state:
Marked basalt rock 16 x 5 x 6" for 1/4 sec. Raised mound of rock as per instructions.

Corner REMONUMENTED by USDI-BLM in 1983 under Group No. 1169, Oregon... The 1/4 sec cor of secs 15 & 16 monumented with the original basalt stone 19 x 7 x 7" (record, 16 x 6 x 5") loosely set 3" in ground in flat mound of stone 2 1/2' base mkd. 1/4 on W face. At the corner point... Set an iron post 28" long 2 1/2" diam 22" in ground in a mound of stone 3' base to top with brass cap mkd. as shown in corner diagram... from which: A twin ponderosa pine 30" diam bears N28 3/4° E, 484 lks dist mkd 1/4 S15 BT. A ponderosa pine 18" diam bears N63° W, 182 1/4 lks. dist mkd 1/4 S16 BT. Deposit the corner stone and set a steel fence post
Description of corner evidence found: alongside the iron post.

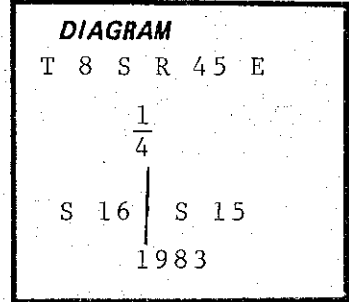

Found a 3 1/2" brass cap on 2 1/2" iron pipe marked as shown projecting 6" out of ground with a steel fence post alongside and the following accessories:

A split-stem p pine with stems 23" & 30" diam brs N28 3/4° E, 484 lks dist with partially healed blaze mkd 1/4 S15 BT and BLM sign S-9 dated 10-83 by WDK. A p pine 20" diam brs N63° W, 182 lks dist with partially healed blaze mkd 1/4 S16 BT and BLM sign S-9 dated 10-83 by WDK.

Description of monument and accessories | established to perpetuate the original location of this corner:

MAINTAINED corner position by improving surrounding rock mound, attaching sign 54-9 to steel fence post alongside and painting blaze and red band of paint around BLM BT's and attaching signs 54-3 and 54-9.

Compass declination 20° East.

I hereby certify that the above described corner monument was properly maintained by me on March 3, 1987.

**REGISTERED
PROFESSIONAL
LAND SURVEYOR**

William L. Hanley

OREGON
JULY 14, 1978
WILLIAM L. HANLEY
1639

Office of... County Surveyor..... County of... Baker.....
State of... Oregon....., I hereby certify that the within instrument was filed in this office
for record on the..... day of....., 19.....
..... by
(COUNTY OFFICIAL) (DEPUTY)

FILED 4/15/87
BAKER COUNTY SURVEYOR
SURVEY NO. 8/45/78