


CERTIFIED RECORD OF LAND CORNER MONUMENTATION

N-7

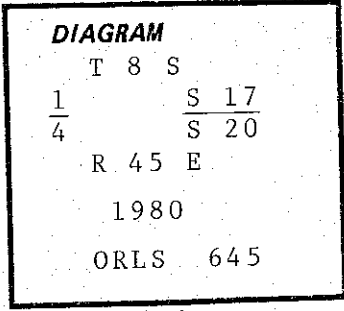

History of original corner establishment:

Corner established by W.B. Barr under GLO contract no. 358 dated June 14, 1880.

Surveyor General records state:
Marked basalt rock 16 x 10 x 10". Raised mound of rock as per instructions.

Corner REMONUMENTED by J. Hambleton, see record of Baker County Survey #8-45-14... Found a basalt stone 17 x 10 x 9 setting upright in a mound of stone. This stone fit very closely the description of the original stone, and the markings were very dim. I also found the GLO calls along this line to be erroneous and not fitting any of the topography. At the 1/4 cor loc I set a 2"x30" galv iron pipe with brass cap along south side of the original stone, leaving the stone in its original position. I then placed a large mound of stone about the monument and stone as it was impossible to bury the pipe. There was no accessories available.

Description of corner evidence found:

Found a 2 1/2" dia brass cap on 2 1/2" galv iron pipe protruding 10" out of large rock mound marked as shown (NOTE: This monument is 13' South of line of active fence and 20' South of line of old rock jacks).

Description of monument and accessories | established to perpetuate the original location of this corner:

MAINTAINED corner position by improving surrounding rock mound and setting steel fence post alongside with sign 54-9 attached and marking the following bearing objects, there being no trees within limits.

A basalt boulder 32" x 38" projecting 18" out of the ground bears S32°W, 36.5' distant marked "BXO" on its center top, distance taken to "X". Painted boulder red.

A basalt boulder 23" x 38" projecting 30" out of the ground bears N85°E, 67.3' distant marked "BXO" on its center top, distance taken to "X". Painted boulder red.

Compass declination 20° East.

I hereby certify that the above described corner monument was properly maintained by me on March 12, 1987.

**REGISTERED
PROFESSIONAL
LAND SURVEYOR**

William L. Hanley

**OREGON
JULY 14, 1978
WILLIAM L. HANLEY
1639**

Office of... County Surveyor..... County of... Baker.....

State of... Oregon....., I hereby certify that the within instrument was filed in this office

for record on the..... day of....., 19.....

..... by

(COUNTY OFFICIAL)

(DEPUTY)

FILED 4/15/87
BAKER COUNTY SURVEYOR
SURVEY NO. 8/45/80