


CERTIFIED RECORD OF LAND CORNER MONUMENTATION

N-9

History of original corner establishment:

Corner established by W.B.Barr under GLO contract no. 358 dated June 14, 1880.

Surveyor General records state:
Marked basalt rock 12 x 12 x 10" for corner to secs 16, 17, 20 & 21. Raised mound of rocks as per instructions.

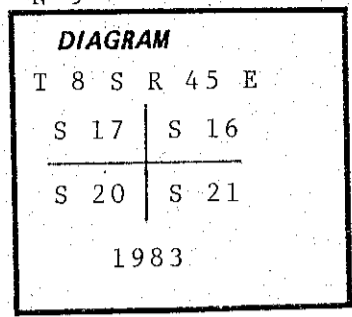

Corner REMONUMENTED by USDI-BLM in 1983 under Group No. 1169, Oregon...The cor of secs 16, 17, 20 & 21 monumented with the orig. basalt stone 14 x 10 x 8" (record, 12 x 12 x 10") loosely set 3" in the ground, mkd with 3 notches on S edge. At the corner point...Set an iron post 28" long 2½" diam 14" in the ground to solid rock in a mound of stone 4' base to top with brass cap mkd. (as shown in corner diagram). From which the marks BXO chisled in a 6' high rock outcrop, bears N77½°E, 228 lks dist. Deposit the corner stone and set a steel fence post alongside the iron post.

Description of corner evidence found:

Found a 3½" brass cap on 2½" iron pipe proj 4" out of large surrounding rock mound marked as shown which is 40' South of E-W fence line and bears S78°W, 3.37 chains from a fence corner from which fences run N, E, W.

Also found the following accessory...a 6' high rock outcrop which bears N77½°E, 228 lks marked B X O (BLM bearing object).

Description of monument and accessories | established to perpetuate the original location of this corner:

MAINTAINED by attaching sign 54-9 to fence post alongside and marking the following bearing object.

Bearing object established:
A rock outcrop 2' high and 12' x 12' bears S18½°E, 23.6' dist marked "B X O" on North center edge.

Painted new and old bearing objects with red paint.

Compass declination 20° East.

I hereby certify that the above described corner monument was properly maintained by me on March 3, 1987.

**REGISTERED
PROFESSIONAL
LAND SURVEYOR**

William L. Hanley

**OREGON
JULY 14, 1978
WILLIAM L. HANLEY
1639**

Office of...County Surveyor..... County of...Baker.....
State of...Oregon....., I hereby certify that the within instrument was filed in this office
for record on the..... day of....., 19.....
..... by
(COUNTY OFFICIAL) (DEPUTY)

FILED 4/15/87
BAKER COUNTY SURVEYOR
SURVEY NO. 8/45/81