

CERTIFIED RECORD OF LAND CORNER MONUMENTATION

N-13

**History of original corner establishment:**


Corner established by W.B. Barr under GLO contract no. 358 dated June 14, 1880.

Surveyor General records state:

Marked basalt rock 16 x 10 x 6" for corner to Secs 15, 16, 21 & 22. Raised mound of rock as per instructions.

Corner ESTABLISHED by USDI-BLM in 1983 under Group No. 1169, Oregon... Point for the cor of secs 15, 16, 21

and 22 at proportionate distance: there is no remaining evidence of the original corner. Set an iron post 28" long 2½" diam 18" in the ground to solid rock, in a mound of stone, 2½' base, to top, with brass cap marked (as shown in corner diagram).

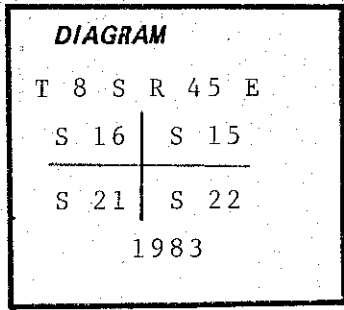

**Description of corner evidence found:**

Found: A 3½" brass cap on 2½" iron pipe projecting 6" out of ground with surrounding rock mound and marked as shown, 4' S of E-W fence line. (A fence corner bears East 4.75 chains from which the fence runs South & West.)

**Description of monument and accessories I established to perpetuate the original location of this corner:**

MAINTAINED corner monument by improving surrounding rock mound and placing a sign 54-9 on fence post 4' North and establishing the following reference monuments - there being no trees or bearing objects within limits.


Reference monuments established: A 5/8" x 30" rebar in fence line set 15" to refusal brs N77½°E, 20.0' dist with aluminum cap attached and marked as shown...

A 5/8" x 30" rebar in fence line and driven 15" to refusal brs N80°W, 19.9' dist with 1½" aluminum cap attached and marked thus.

Each rebar reference monument has a steel fence post alongside with signs 54-3 and 54-9 attached.

Compass declination 20° East.

I hereby certify that the above described corner monument was properly maintained by me on March 2, 1987.

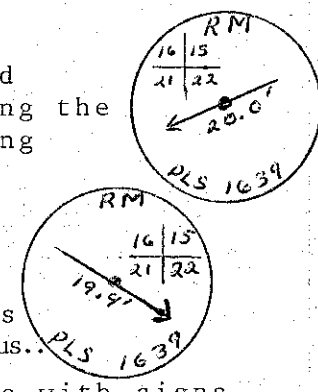

**REGISTERED  
PROFESSIONAL  
LAND SURVEYOR**

*William L. Hanley*

**OREGON  
JULY 14, 1978  
WILLIAM L. HANLEY  
1639**

Office of...County Surveyor..... County of...Baker.....  
State of...Oregon..... I hereby certify that the within instrument was filed in this office  
for record on the..... day of....., 19.....

..... by .....  
(COUNTY OFFICIAL) (DEPUTY)

FILED 4/15/87  
BAKER COUNTY SURVEYOR  
SURVEY NO. 8/45/83