

CERTIFIED RECORD OF LAND CORNER MONUMENTATION


N-15

History of original corner establishment:

Corner established by W.B. Barr under GLO contract no. 358 dated June 14, 1880.

Surveyor General records state:
Marked basalt rock 14 x 9 x 5" for 1/4 sec cor.
Raised mound of rocks as per instructions.

Corner REMONUMENTED by USDI-BLM in 1983 under Group No. 1169, Oregon... From the 1/4 sec cor of secs 15 and 22 monumented with the original basalt stone 16 x 10 x 5" (record 14 x 9 x 5") mkd. 1/4 on N face in a mound of stone 2' base 1' high. At the corner point. Set an iron post 28" long 2 1/2" diam 22" in ground in a mound of stone 3' base to top with brass cap mkd. (as shown in corner diagram). Deposit the corner stone and set a steel fence post alongside the iron post. From which: The mark BXO chiseled in exposed rock outcrop 6 x 5 x 5' above ground bears N28 1/2° E, 47 lks dist.

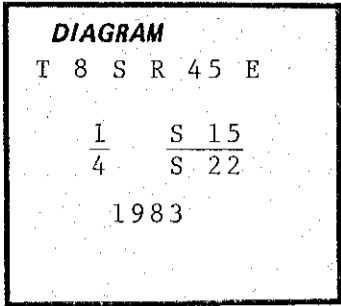

Description of corner evidence found:


Found a 3 1/2" brass cap on 2 1/2" iron pipe projecting 4" out of ground marked as shown with surrounding rock mound and steel fence post alongside and the following accessory...

A rock outcrop 6 x 5' and projecting 5' out of ground bears N28 1/2° E, 47 lks dist and marked "BXO".

Description of monument and accessories established to perpetuate the original location of this corner:

MAINTAINED to USFS standards by improving rock mound and attaching sign 54-9 to fence post alongside monument, painted existing bearing object and by establishing the following reference monument, there being no trees or suitable bearing objects within limits.

Reference monument established:
A 5/8" x 30" rebar driven 25" in the ground brs S17 1/2° W, 58.2' dist with 1 1/2" diam aluminum cap attached and marked as shown with steel fence post alongside with signs 54-3 and 54-9 attached.

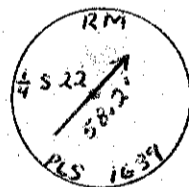

Compass declination 20° East.

I hereby certify that the above described corner monument was properly maintained by me on March 8, 1987.

**REGISTERED
PROFESSIONAL
LAND SURVEYOR**

William L. Hanley

**OREGON
JULY 14, 1978
WILLIAM L. HANLEY
1639**

Office of... County Surveyor County of... Baker
Oregon
State of....., I hereby certify that the within instrument was filed in this office
for record on the..... day of....., 19.....

..... by
(COUNTY OFFICIAL) (DEPUTY)

FILED 4/15/87
BAKER COUNTY SURVEYOR
SURVEY NO. 8/45/84