

CERTIFIED RECORD OF LAND CORNER MONUMENTATION


V-21

History of original corner establishment:

Corner established by W.B. Barr under GLO contract no. 358 dated June 14, 1880.

Surveyor General records state:
Marked basalt rock 14 x 10 x 6" for corner to Sec. 25 x 26 x 35 x 36. Raised mound of rock as per instructions

Corner REMONUMENTED by USDI-BLM in 1983 under Group No. 1169, Oregon...The cor of secs 25,26,35 & 36 monumented with the original basalt stone 15 x 8 x 6" (record 14 x 10 x 6") firmly set 5" in the ground mkd with 1 notch on E and 1 notch on the S edges. At the corner point...Set an iron post 28" long 2 1/2" diam 16" in the ground to solid rock in a mound of stone 3' base to top with brass cap marked (as shown in corner diagram). Deposit the corner stone alongside the iron post.

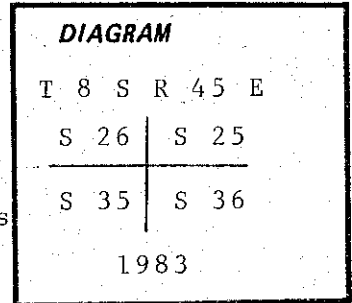

Description of corner evidence found:

Found, 3 1/2" brass cap on 2 1/2" iron pipe projecting 12" out of surrounding rock mound.

Description of monument and accessories established to perpetuate the original location of this corner:

MAINTAINED corner by improving surrounding rock mound and placing a steel fence post alongside with a sign 54-9 attached and by marking the following bearing objects, there being no suitable trees available.

A rock out-crop 3'x4' and projecting 5' out of ground at South tip of rimrock ledge bears N30° W, 123.5' dist marked "BX0" on its top.
A basalt boulder 20"x27" and projecting 15" out of ground bears S42 1/2° W, 71.3' dist marked "BX0" on its North edge.

Both bearing objects are painted red and bearings and distances are taken to intersection of "X".

Compass declination 20° East.

I hereby certify that the above described corner monument was properly maintained by me on March 15, 1987.

REGISTERED
PROFESSIONAL
LAND SURVEYOR

William L. Hanley

OREGON
JULY 14, 1978
WILLIAM L. HANLEY
1639

Office of...County Surveyor..... County of...Baker.....
State of...Oregon....., I hereby certify that the within instrument was filed in this office
for record on the..... day of....., 19.....

..... by
(COUNTY OFFICIAL) (DEPUTY)

FILED 4/15/87
BAKER COUNTY SURVEYOR
SURVEY NO. 8/45/89