

CERTIFIED RECORD OF LAND CORNER MONUMENTATION


G-17

History of original corner establishment:

Corner established by W. B. Barr under GLO contract no. 355 dated June 14, 1880.

Surveyor General records state:

Marked basalt rock 15 x 9 x 5" for 1/4 Sec corner. Raised mound of rocks as per instructions.

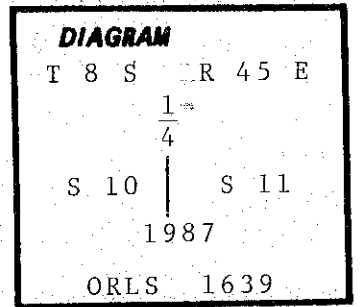

Description of corner evidence found:

None, original corner probably destroyed by Forest road #77 construction.

Description of monument and accessories established to perpetuate the original location of this corner:

At midpoint between Northeast and Southeast corners of sec 10 as determined by survey...

Set 2 1/2" aluminum cap on 2" aluminum pipe 23" in ground with 7" projecting out of ground with surrounding rock mound and 6' fence post along with signs 54-9.

New bearing trees established:

A p pine 24" diam bears N27°E, 101.4' dist marked 1/4S11 BT.

A p pine 17" diam bears N86°W, 135.3' dist marked 1/4S10 BT.

Each new BT has a band of red paint, painted blaze, a brass washer marked PLS 1639 nailed flush to BT blaze and signs 54-3 & 54-9 attached.

Compass declination 20° East.

I hereby certify that the above described corner monument was properly reestablished by me and witnessed by Jim DeMastus on April 24, 1987.

REGISTERED
PROFESSIONAL
LAND SURVEYOR

William L. Hanley

OREGON
JULY 14, 1978
WILLIAM L. HANLEY
1639

Office of... County Surveyor... County of... Baker

State of... Oregon... I hereby certify that the within instrument was filed in this office

for record on the... day of... , 19...

..... by

(COUNTY OFFICIAL)

(DEPUTY)

FILED 4/29/87
BAKER COUNTY SURVEYOR
SURVEY NO. 8-45-90