

CERTIFIED RECORD OF LAND CORNER MONUMENTATION


J-11

History of original corner establishment:

Corner established by W. B. Barr under GLO contract no. 355 dated June 14, 1880.

Surveyor General records state:

Marked basalt rock 15 x 8 x 8" for 1/4 Sec corner.
Raised mound of rocks as per instructions.

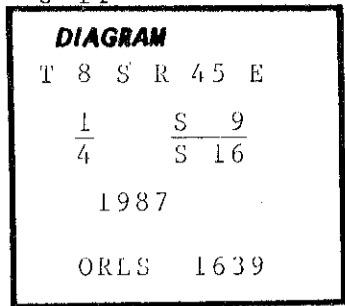

Description of corner evidence found:

Found broken basalt stone 15 x 7 x 6" (record states 15 x 8 x 4) in middle of lone rock mound marked 1/4.

Description of monument and accessories established to perpetuate the original location of this corner:

At position of original stone...

Set 2½" aluminum cap on 2" aluminum pipe 15" in ground to bedrock with 15" projecting out of ground with surrounding rock mound and 6' fence post alongside with sign 54-9 attached. Buried original stone alongside.

New bearing trees established:

A p pine 13" diam bears N75°E, 232.1' dist marked 1/4S9 BT.

A p pine 9" diam bears S50°E, 158.9' dist marked 1/4S16 BT.

Each new BT has a band of red paint, painted blaze, a brass washer marked PLS 1639 nailed flush to BT blaze and signs 54-3 and 54-9 attached.

Compass declination 20° East.

I hereby certify that the above described corner monument was properly remonumented by me and witnessed by Jim DeMastus on April 20, 1987.

REGISTERED
PROFESSIONAL
LAND SURVEYOR

William L. Hanley

OREGON
JULY 14, 1978
WILLIAM L. HANLEY
1639

Office of... County Surveyor..... County of... Baker.....

State of... Oregon....., I hereby certify that the within instrument was filed in this office

for record on the..... day of....., 19.....

..... by

(COUNTY OFFICIAL)

(DEPUTY)

FILED 4/29/87
BAKER COUNTY SURVEYOR
CLERK NO. 8-45-91