

CERTIFIED RECORD OF LAND CORNER MONUMENTATION


J-15

History of original corner establishment:

Corner established by W. B. Barr under GLO contract no. 355 dated June 14, 1880.

Surveyor General records state:

Marked basalt rock 15 x 12 x 5" for 1/4 Sec Cor. Raised mound of rocks as per instructions.

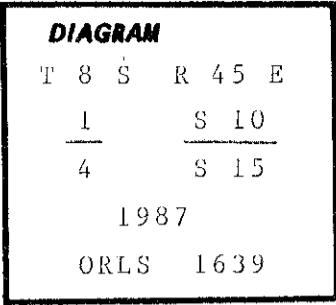

Description of corner evidence found:

Found basalt stone 18 x 14 x 5" (record states 15 x 12 x 5) marked 1/4 in small mound of stone.

Description of monument and accessories established to perpetuate the original location of this corner:

At position of found stone...

Set 2 1/2" aluminum cap on 2" aluminum pipe 25" in ground with 5" projecting out of ground with surrounding rock mound and 6' fence post along with sign 54-9. Buried original stone alongside.

New bearing trees established;

A p pine 11" diam bears N31 1/2° E, 39.6' dist marked 1/4 S10 BT.

A fir 16" diam bears S68 1/2° E, 7.6' dist marked 1/4 S15 BT.

Each new BT has a band of red paint, painted blaze, a brass washer marked PLS 1639 nailed flush to BT blaze and signs 54-3 & 54-9 attached.

Compass declination 20° East.

I hereby certify that the above described corner monument was properly remonumented by me and witnessed by Jim DeMastus on April 24, 1987.

REGISTERED
PROFESSIONAL
LAND SURVEYOR

William L. Hanley

OREGON
JULY 14, 1978
WILLIAM L. HANLEY
1639

Office of..... County Surveyor..... County of..... Baker.....

State of..... Oregon....., I hereby certify that the within instrument was filed in this office for record on the..... day of....., 19.....

..... by
(COUNTY OFFICIAL) (DEPUTY)

FILED 4/29/87
Baker County Surveyor
Surveyed 8-45-92