

CERTIFIED RECORD OF LAND CORNER MONUMENTATION


J-17

History of original corner establishment:

Corner established by W. B. Barr under GLO contract no. 355 dated June 14, 1880.

Surveyor General records state:

Marked basalt rock 14 x 12 x 4" for corner Sec 10 x 11 x 14 x 15 as per instructions, from which: Pine 4" diam bears N6 $\frac{1}{2}$ ⁰E, 76 lks dist. No other trees.

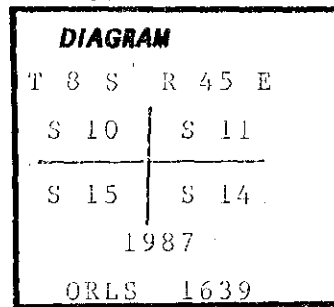

Description of corner evidence found:

Found undisturbed rock mound with stone 14 x 11 x 4" (record states 14 x 12 x 4) - no marks identified.
No trace of record bearing tree found.

Description of monument and accessories established to perpetuate the original location of this corner:

At position of found stone...Set 2 $\frac{1}{2}$ " aluminum cap on 2" aluminum pipe 25" in ground with 5" projecting out of ground with surrounding rock mound and 6' fence post alongside with sign 54-9 attached. Buried unmarked stone alongside.

New bearing trees established:

- A p pine 10" diam bears N15⁰E, 20.0' dist marked T8SR45ES11 BT.
- A p pine 10" diam bears S60 $\frac{1}{2}$ ⁰E, 10.2' dist marked T8SR45ES14 BT.
- A p pine 9" diam bears S32 $\frac{1}{2}$ ⁰W, 22.0' dist marked T8SR45ES15 BT.
- A p pine 9" diam bears N13⁰W, 9.0' dist marked T8SR45ES10 BT.

Each new BT has a band of red paint, painted blaze, a brass washer marked PLS 1639 nailed flush to BT blaze and signs 54-3 and 54-9 attached.

Compass declination 20⁰ East.

I hereby certify that the above described corner monument was properly remonumented by me and witnessed by Jim DeMastus on April 13, 1987.

REGISTERED
PROFESSIONAL
LAND SURVEYOR

William L Hanley

OREGON
JULY 14, 1978
WILLIAM L HANLEY
1639

Office of County Surveyor..... County of Baker.....
Oregon
State of....., I hereby certify that the within instrument was filed in this office
for record on the..... day of....., 19.....
..... by
(COUNTY OFFICIAL) (DEPUTY)

Form R6-7100-57 (9/71)

☆ GPO—788-276

FILED 4/29/87
BAKER COUNTY SURVEYOR
SERIAL NO. 8-45-93