

CERTIFIED RECORD OF LAND CORNER MONUMENTATION


L-9

History of original corner establishment:

Corner established by W. B. Barr under GLO contract no. 355 dated June 14, 1880.

Surveyor General records state:

Marked basalt rock 15 x 14 x 10" for 1/4 Sec corner.
Raised mound of rocks as per instructions.

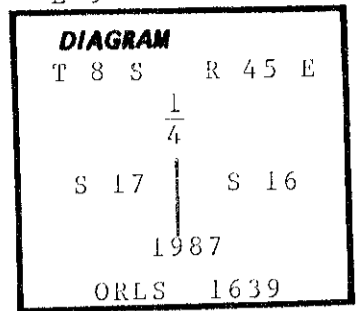

Description of corner evidence found:

A basalt stone 13 x 13 x 6" (record states 15 x 14 x 10) in mound of stone marked 1/4.

Description of monument and accessories established to perpetuate the original location of this corner:

At position of found original stone in center of rock mound... Set 2 1/2" aluminum cap on 2" aluminum pipe 25" in ground with 5" projecting out of ground with surrounding rock mound and 6' fence post alongside with signs 54-2 & 54-9 attached. Buried original stone alongside.

There being no trees available, I marked the following bearing objects. A basalt boulder 21 x 21" projecting 18" out of ground bears S65°W, 121.1' dist marked "BXO". A basalt boulder 18 x 20" projecting 10" out of ground bears S41 1/2°E, 139.7' dist marked "BXO". Each bearing object is painted red.

Compass declination 20° East.

I hereby certify that the above described corner monument was properly remonumented by me and witnessed by Jim DeMastus on April 21, 1987.

REGISTERED
PROFESSIONAL
LAND SURVEYOR

William L. Hanley

OREGON
JULY 14, 1978
WILLIAM L. HANLEY
1639

Office of... County Surveyor County of... Baker
State of... Oregon I hereby certify that the within instrument was filed in this office
for record on the..... day of....., 19.....

..... by
(COUNTY OFFICIAL) (DEPUTY)

FILED 4/29/87

COUNTY SURVEYOR

DEPUTY NO. 8-45-94