

CERTIFIED RECORD OF LAND CORNER MONUMENTATION


N-19

History of original corner establishment:

Corner established by W. B. Barr under GLO contract no. 355 dated June 14, 1880.

Surveyor General records state:

Marked basalt rock 24 x 12 x 10" for 1/4 Sec corner.
Raised mound of rock as per instructions.

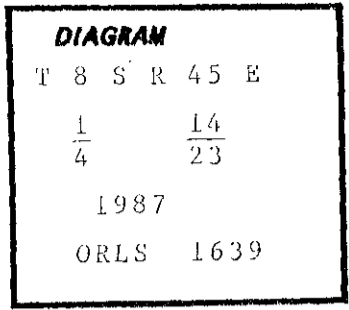

Description of corner evidence found:

Found large undisturbed lone rock mound with stone of record size with no marks identified.

Description of monument and accessories established to perpetuate the original location of this corner:

At center of mound of stones...
Set 2½" aluminum cap on 2" aluminum pipe 20" in ground with 5" projecting out of ground with surrounding rock mound and 6' fence post alongside with sign 54-9 attached. Buried unmarked stone alongside.

New bearing tree established: A p pine 20" diam bears N01°E, 221.0' dist marked 1/4S14 BT.

There being no other trees within limits, I marked the following bearing object...A lava boulder 36 x 20" projecting 40" out of ground bears S49°W, 17.8' dist marked "BX0".

Compass declination 20° East.

I hereby certify that the above described corner monument was properly remonumented by me and witnessed by Jim DeMastus on April 20, 1987.

NOTE: The new BT has a band of red paint, painted blaze, a brass washer marked PLS 1639 nailed flush to BT blaze and signs 54-3 and 54-9 attached. Bearing object is painted red.

REGISTERED
PROFESSIONAL
LAND SURVEYOR

William L. Hanley

OREGON
JULY 14, 1978
WILLIAM L. HANLEY
1639

Office of... County Surveyor..... County of... Baker
Oregon....., I hereby certify that the within instrument was filed in this office
for record on the..... day of....., 19.....
..... by
(COUNTY OFFICIAL) (DEPUTY)

FILED 4/29/87
COUNTY SURVEYOR
8-45-95