

CERTIFIED RECORD OF LAND CORNER MONUMENTATION


N-21

History of original corner establishment:

Corner established by W.B. Barr under GLO contract no. 355 dated June 14, 1880.

Surveyor General records state:

Marked basalt rock 15 x 12 x 11" for corner to Sec 13 x 14 x 23 x 24. Raised mound of rocks per instructions.

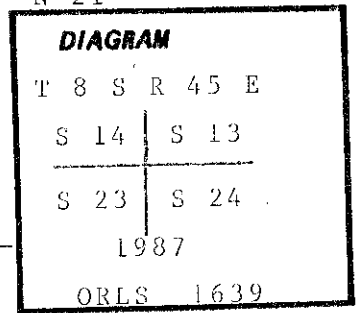

Description of corner evidence found:

Found: Corner stone and mound not found - position reestablished by record topo calls from original survey to canyon 7 chains South and 7.65 chains East. This position is verified by record topo calls E, W & S and recovered quarter corner 1/2 mile West.

Description of monument and accessories established to perpetuate the original location of this corner:

Re-established corner by record topo calls... Set 2 1/2" aluminum cap on 2" aluminum pipe 25" in ground with 5" projecting out of ground with surrounding rock mound and 6' fence post 3' South with sign 54-9 attached.

New bearing trees established:

- A p pine 21" diam bears N48°E, 64.7' dist marked T8SR45ES13 BT.
- A p pine 22" diam bears S46 1/2°E, 136.0' dist marked T8SR45ES24 BT.
- A p pine 14" diam bears S09°W, 194.6' dist marked T8SR45ES23 BT.
- A fir 26" diam bears N03°W, 166.7' dist marked T8SR45ES14 BT.

Each new BT has a band of red paint, painted blaze, a brass washer marked PLS 1639 nailed flush to BT blaze and signs 54-3 and 54-9 attached.

Compass declination 20° East.

I hereby certify that the above described corner monument was properly re-established by me and witnessed by Jim DeMastus on April 13, 1987.

REGISTERED PROFESSIONAL LAND SURVEYOR

William L Hanley

OREGON JULY 14, 1978 WILLIAM L HANLEY 1639

Office of...County Surveyor..... County of...Baker..... State of...Oregon....., I hereby certify that the within instrument was filed in this office for record on the..... day of....., 19.....

..... by (COUNTY OFFICIAL) (DEPUTY)

FILED 4/29/87 COUNTY SURVEYOR NO. 8-45-96