

CERTIFIED RECORD OF LAND CORNER MONUMENTATION


R-17

History of original corner establishment:

Corner established by W. B. Barr under GLO contract no. 355 dated June 14, 1880.

Surveyor General records state:

Marked basalt rock 18 x 18 x 8" for corner Sec 22 x 23 x 26 x 27.
Raised mound of rock as per instructions.

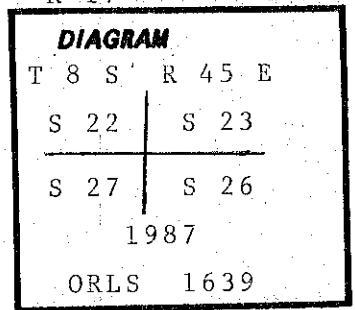

Description of corner evidence found:

Lone rock mound 4' x 4' nearly flush with ground with stone 15 x 9 x 8" (record states 18 x 18 x 8) with 2 notches on one face - face for other notches previously broken. (NOTE: This position does not fit with record topo calcs but is a positive recovery.)

Description of monument and accessories established to perpetuate the original location of this corner:

At position of found stone...Set 2 1/2" aluminum cap on 2" aluminum pipe 25" in ground with 5" projecting out of ground with surrounding rock mound and 6' fence post alongside with sign 54-9 attached. Buried original stone alongside.

New bearing trees established and bearing object established:
A p pine 16" diam bears N45 1/2° W, 175.3' dist marked T8SR45E22 BT with red band above signs 54-3 and 54-9 and brass washer marked PLS 1639 nailed flush with painted BT blaze.
A basalt boulder 30 x 25" projecting 18" out of ground bears S62° W, 214.1' dist marked BX0 and painted with red paint.

Compass declination 20° East.

I hereby certify that the above described corner monument was properly remonumented by me and witnessed by Jim DeMastus on April 15, 1987.

REGISTERED
PROFESSIONAL
LAND SURVEYOR

William L. Hanley

OREGON
JULY 14, 1978
WILLIAM L. HANLEY
1639

Office of...County Surveyor..... County of...Baker.....
State of...Oregon....., I hereby certify that the within instrument was filed in this office
for record on the..... day of....., 19.....

..... by
(COUNTY OFFICIAL) (DEPUTY)

FILED 4/29/87
BAKER COUNTY SURVEYOR
SURVEY NO. 8-45-97